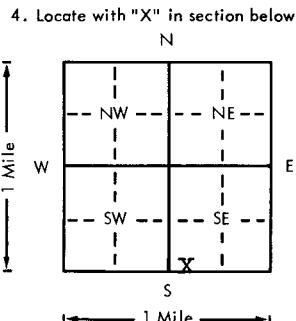


1. Location of well:	County Butler	Fraction SW 1/4 SE 1/4	1/4	Section number 14	Township number T 27 S R 3E	Range number E/W
2. Distance and direction from nearest town or city: 3 1/2 East of Andover on Central, Street address of well location if in city: North side of Rd.	3. Owner of well: Hartman Homes R.R. or street: 6416 East. Central City, state, zip code: Wichita, Kansas					
4. Locate with "X" in section below: 	Sketch map: Andover, Kansas					
5. Type and color of material	From	To				
Topsoil	0	3				
Brown Clay	3	11				
Light Brown Shale	11	30				
Blue Shale	30	55				
Light Brown Shale	55	70				
Grey Shale	70	140				
(Use a second sheet if needed)						
18. Elevation:	19. Remarks: Septic System not installed when the well was drilled. No apparent source for contamination.					20. Water well contractor's certification: This well was drilled under my jurisdiction and this report is true to the best of my knowledge and belief. Harp Well & Pump 236 Business name: Wichita, Kansas License No. Address: m. Arnold Date: 8-12-77 Signed m. Arnold Authorized representative 8-12-77
Topography: <input type="checkbox"/> Hill <input checked="" type="checkbox"/> Slope <input type="checkbox"/> Upland <input type="checkbox"/> Valley						