

WATER WELL RECORD Form WWC-5 KSA 82a-1212

1 LOCATION OF WATER WELL:

County: Butler

Fraction

SE 1/4 NW 1/4 SE 1/4

Section Number

Township Number

Range Number

T 27 S

R 3 EW

Distance and direction from nearest town or city street address of well if located within city?

5 W - 2 N of Augusta

2 WATER WELL OWNER:

RR#, St. Address, Box #:


City, State, ZIP Code:

Darrell Cremoore Augusta, Kansas

Board of Agriculture, Division of Water Resources

Application Number:

3 LOCATE WELL'S LOCATION WITH AN "X" IN SECTION BOX:

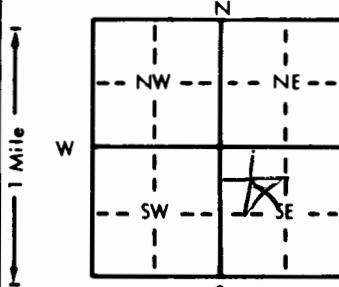

4 DEPTH OF COMPLETED WELL ft. ELEVATION:

Depth(s) Groundwater Encountered 110 ft. 2. ft. 3. ft.WELL'S STATIC WATER LEVEL 60 ft. below land surface measured on mo/day/yr

Pump test data: Well water was ft. after hours pumping gpm

Est. Yield 30 gpm Well water was ft. after hours pumping gpmBore Hole Diameter 81 in. to ft., and. in. to ft.

WELL WATER TO BE USED AS: 5 Public water supply 8 Air conditioning 11 Injection well

① Domestic 3 Feedlot 6 Oil field water supply 9 Dewatering 12 Other (Specify below)

2 Irrigation 4 Industrial 7 Lawn and garden only 10 Monitoring well

Was a chemical/bacteriological sample submitted to Department? Yes No If yes, mo/day/yr sample was submittedWater Well Disinfected? Yes No

5 TYPE OF BLANK CASING USED:

1 Steel 3 RMP (SR)
② PVC 4 ABS

5 Wrought iron

8 Concrete tile

CASING JOINTS: Glued Clamped 6 Asbestos-Cement
7 Fiberglass

9 Other (specify below)

Welded Threaded Blank casing diameter 5 in. to 60 ft., Dia. in. to ft., Dia. in. to ft.Casing height above land surface 18 in., weight 160 lbs./ft. Wall thickness or gauge No. 1214

TYPE OF SCREEN OR PERFORATION MATERIAL:

1 Steel 3 Stainless steel
2 Brass 4 Galvanized steel5 Fiberglass
6 Concrete tile8 RMP (SR)
9 ABS

10 Asbestos-cement

11 Other (specify) 12 None used (open hole)

SCREEN OR PERFORATION OPENINGS ARE:

1 Continuous slot 3 Mill slot
2 Louvered shutter 4 Key punched5 Gauzed wrapped
6 Wire wrapped

8 Saw cut

11 None (open hole)

7 Torch cut

9 Drilled holes

10 Other (specify) SCREEN-PERFORATED INTERVALS: From 60 ft. to 135 ft., From ft. to ft., From ft. to ft.

From ft. to ft., From ft. to ft., From ft. to ft.

GRAVEL PACK INTERVALS: From ft. to ft., From ft. to ft., From ft. to ft.

From ft. to ft., From ft. to ft., From ft. to ft.

6 GROUT MATERIAL: 1 Neat cement ② Cement grout 3 Bentonite 4 OtherGrout Intervals: From 0 ft. to 20 ft., From ft. to ft., From ft. to ft.

What is the nearest source of possible contamination:

1 Septic tank 4 Lateral lines
2 Sewer lines 5 Cess pool
3 Watertight sewer lines 6 Seepage pit7 Pit privy
8 Sewage lagoon
9 Feedyard

10 Livestock pens

14 Abandoned water well

11 Fuel storage

15 Oil well/Gas well

12 Fertilizer storage

16 Other (specify below)

13 Insecticide storage

Direction from well? S-E How many feet? 1857 CONTRACTOR'S OR LANDOWNER'S CERTIFICATION: This water well was ① constructed, (2) reconstructed, or (3) plugged under my jurisdiction and was completed on (mo/day/year) 11/13/92 and this record is true to the best of my knowledge and belief. KansasWater Well Contractor's License No. 1257 This Water Well Record was completed on (mo/day/yr) 11/14/92under the business name of Winter Well Drill by (signature) Charles Winter