

1 LOCATION OF WATER WELL:

County: Butler Fraction: SE 1/4 NW 1/4 SE 1/4 Section Number: 27 Township Number: 28 Range Number: 3

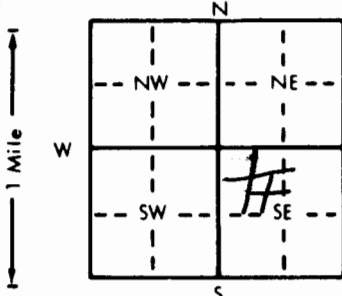
Distance and direction from nearest town or city street address of well if located within city?

East of Gordon Kan 5 west 2 North of Augusta

2 WATER WELL OWNER:

RR#, St. Address, Box #: Dennis Daurity Board of Agriculture, Division of Water Resources
City, State, ZIP Code: PO Box 440 Augusta Kan 67010 Application Number:

3 LOCATE WELL'S LOCATION WITH AN "X" IN SECTION BOX:

4 DEPTH OF COMPLETED WELL: 145 ft. ELEVATION:Depth(s) Groundwater Encountered: 1 ft. 2. ft. 3. ft.WELL'S STATIC WATER LEVEL: 65 ft. below land surface measured on mo/day/yr

Pump test data: Well water was ft. after hours pumping gpm

Est. Yield: 50 gpm Well water was ft. after hours pumping gpmBore Hole Diameter: 2 1/2 in. to ft., and in. to ft.

WELL WATER TO BE USED AS: 5 Public water supply 8 Air conditioning 11 Injection well

1 Domestic 3 Feedlot 6 Oil field water supply 9 Dewatering 12 Other (Specify below)

2 Irrigation 4 Industrial 7 Lawn and garden only 10 Monitoring well

Was a chemical/bacteriological sample submitted to Department? Yes No; If yes, mo/day/yr sample was submitted

Water Well Disinfected? Yes X No

5 TYPE OF BLANK CASING USED:

1 Steel 3 RMP (SR) 5 Wrought iron 8 Concrete tile CASING JOINTS: Glued X Clamped

2 PVC 4 ABS 6 Asbestos-Cement 9 Other (specify below) Welded

Blank casing diameter: 5 in. to 60 ft., Dia. in. to ft., Dia. in. to ft.Casing height above land surface: 18 in., weight 160 lbs./ft. Wall thickness or gauge No. 214

TYPE OF SCREEN OR PERFORATION MATERIAL:

1 Steel 3 Stainless steel 5 Fiberglass 8 RMP (SR) 10 Asbestos-cement

2 Brass 4 Galvanized steel 6 Concrete tile 9 ABS 11 Other (specify)

SCREEN OR PERFORATION OPENINGS ARE: 5 Gauzed wrapped 8 Saw cut 11 None (open hole)

1 Continuous slot 3 Mill slot 6 Wire wrapped 9 Drilled holes

2 Louvered shutter 4 Key punched 7 Torch cut 10 Other (specify)

SCREEN-PERFORATED INTERVALS: From 60 ft. to 145 ft., From ft. to ft.

From ft. to ft., From ft. to ft.

GRAVEL PACK INTERVALS: From ft. to ft., From ft. to ft.

From ft. to ft., From ft. to ft.

6 GROUT MATERIAL: 1 Neat cement 2 Cement grout 3 Bentonite 4 Other

Grout intervals: From 3 ft. to 23 ft., From ft. to ft., From ft. to ft.

What is the nearest source of possible contamination:

1 Septic tank 4 Lateral lines 7 Pit privy 10 Livestock pens 14 Abandoned water well

2 Sewer lines 5 Cess pool 8 Sewage lagoon 11 Fuel storage 15 Oil well/Gas well

3 Watertight sewer lines 6 Seepage pit 9 Feedyard 12 Fertilizer storage 16 Other (specify below)

Direction from well? W How many feet? 300

FROM TO LITHOLOGIC LOG FROM TO PLUGGING INTERVALS

0 1 Soil

1 1.5 Rock

1.5 2.5 Clay

2.5 145 Shale & Lime

7 CONTRACTOR'S OR LANDOWNER'S CERTIFICATION: This water well was X constructed, (2) reconstructed, or (3) plugged under my jurisdiction and was completed on (mo/day/year) 2/8/94 and this record is true to the best of my knowledge and belief. KansasWater Well Contractor's License No. 251 This Water Well Record was completed on (mo/day/year) 2/23/94under the business name of Winter Well Drill by (signature) Richard Winter