


1 LOCATION OF WATER WELL: Fraction SE 1/4 SE 1/4 NW 1/4 Section Number 15 Township Number T 27 S Range Number R 3 E/W
 County: Battler

Distance and direction from nearest town or city street address of well if located within city?

3 East of Andover

2 WATER WELL OWNER: Ken Nelson Augusta Kan
 RR#, St. Address, Box #: Box 565
 City, State, ZIP Code: 67010
 Board of Agriculture, Division of Water Resources
 Application Number:

3 LOCATE WELL'S LOCATION WITH AN "X" IN SECTION BOX: 4 DEPTH OF COMPLETED WELL: 108 ft. ELEVATION: 80 ft.
 Depth(s) Groundwater Encountered 1. 80 ft. 2. 80 ft. 3. 80 ft.

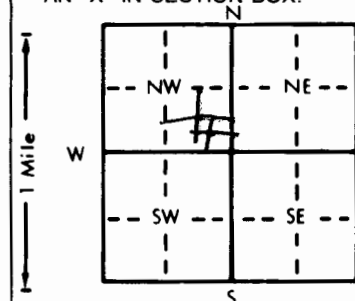

WELL'S STATIC WATER LEVEL 2.5 ft. below land surface measured on mo/day/yr



Bore Hole Diameter 8 1/2 in. to 160 ft. Dia. to 100 ft. Dia.

WELL WATER TO BE USED AS: 5 Public water supply 8 Air conditioning 11 Injection well

1 Domestic 3 Feedlot 6 Oil field water supply 9 Dewatering 12 Other (Specify below)

2 Irrigation 4 Industrial 7 Lawn and garden only 10 Monitoring well

Was a chemical/bacteriological sample submitted to Department? Yes X No X If yes, mo/day/yr sample was submitted

Water Well Disinfected? Yes X No X

5 TYPE OF BLANK CASING USED: 5 Wrought iron 8 Concrete tile CASING JOINTS: Glued X Clamped X

1 Steel 3 RMP (SR) 6 Asbestos-Cement 9 Other (specify below) Welded X

2 PVC 4 ABS 7 Fiberglass Threaded X

Blank casing diameter 5 in. to 60 ft. Dia. 160 in. to 1214 ft. Dia.

Casing height above land surface 18 in., weight 160 lbs./ft. Wall thickness or gauge No. 1214

TYPE OF SCREEN OR PERFORATION MATERIAL: 7 PVC 10 Asbestos-cement

1 Steel 3 Stainless steel 5 Fiberglass 8 RMP (SR) 11 Other (specify)

2 Brass 4 Galvanized steel 6 Concrete tile 9 ABS 12 None used (open hole)

SCREEN OR PERFORATION OPENINGS ARE: 5 Gauzed wrapped 8 Saw cut 11 None (open hole)

1 Continuous slot 3 Mill slot 6 Wire wrapped 9 Drilled holes

2 Louvered shutter 4 Key punched 7 Torch cut 10 Other (specify)

SCREEN-PERFORATED INTERVALS: From 60 ft. to 100 ft. From 100 ft. to 100 ft.




6 GROUT MATERIAL: 1 Neat cement 2 Cement grout 3 Bentonite 4 Other

Grout intervals: From 0 ft. to 20 ft. From 20 ft. to 100 ft. From 100 ft. to 100 ft.

What is the nearest source of possible contamination: 10 Livestock pens 14 Abandoned water well

1 Septic tank 4 Lateral lines 7 Pit privy 11 Fuel storage 15 Oil well/Gas well

2 Sewer lines 5 Cess pool 8 Sewage lagoon 12 Fertilizer storage 16 Other (specify below)

3 Watertight sewer lines 6 Seepage pit 9 Feedyard 13 Insecticide storage

Direction from well? 5 How many feet? 300

FROM TO LITHOLOGIC LOG FROM TO PLUGGING INTERVALS

0 4 Soil 0 4

4 15 Clay 4 15

15 100 Shale & Lime 15 100

7 CONTRACTOR'S OR LANDOWNER'S CERTIFICATION: This water well was (1) constructed, (2) reconstructed, or (3) plugged under my jurisdiction and was completed on (mo/day/year) 5/21/91 and this record is true to the best of my knowledge and belief. Kansas

Water Contractor's License No. 251 This Water Well Record was completed on (mo/day/yr) 5/21/91

under the business name of Winter Water Well Drilling (signature) Charles Winter