

1 LOCATION OF WATER WELL:

Fraction

Section Number

Township Number

Range Number

County: Butler

NE $\frac{1}{4}$ SW $\frac{1}{4}$ NE $\frac{1}{4}$

16

T 27 S

R 3 E

Distance and direction from nearest town or city street address of well if located within city?

NW of Andover

2 WATER WELL OWNER: Khoura Thao Wichita Kan


RR#, St. Address, Box #

City, State, ZIP Code

14441 Siesske 67230

Board of Agriculture, Division of Water Resources
Application Number:

3 LOCATE WELL'S LOCATION WITH AN "X" IN SECTION BOX:

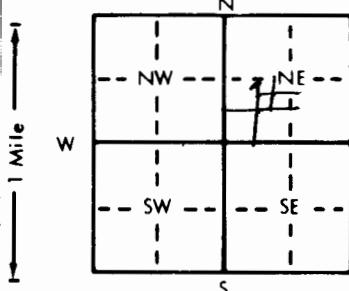

4 DEPTH OF COMPLETED WELL: 75 ft. ELEVATION:

Depth(s) Groundwater Encountered 1.50 ft. 2. ft. 3. ft.

WELL'S STATIC WATER LEVEL 20 ft. below land surface measured on mo/day/yr

Pump test data: Well water was ft. after hours pumping gpm

Est. Yield 20 gpm Well water was ft. after hours pumping gpm

Bore Hole Diameter 75 in. to ft., and in. to ft.

WELL WATER TO BE USED AS: 5 Public water supply 8 Air conditioning 11 Injection well

1 Domestic 3 Feedlot 6 Oil field water supply 9 Dewatering 12 Other (Specify below)

2 Irrigation 4 Industrial 7 Lawn and garden only 10 Monitoring well

Was a chemical/bacteriological sample submitted to Department? Yes No If yes, mo/day/yr sample was submitted

Water Well Disinfected? Yes No

5 TYPE OF BLANK CASING USED:

1 Steel 3 RMP (SR)
2 PVC 4 ABS

5 Wrought iron 8 Concrete tile Casing joints: Glued X Clamped

6 Asbestos-Cement 9 Other (specify below) Welded

Threaded

Blank casing diameter 5 in. to 35 ft. Dia in. to ft. Dia in. to ft.

Casing height above land surface 18 in. weight 160 lbs./ft. Wall thickness or gauge No. 214

TYPE OF SCREEN OR PERFORATION MATERIAL:

1 Steel 3 Stainless steel
2 Brass 4 Galvanized steel5 Fiberglass 8 RMP (SR)
6 Concrete tile 9 ABS

PVC

10 Asbestos-cement

11 Other (specify)

12 None used (open hole)

SCREEN OR PERFORATION OPENINGS ARE:

1 Continuous slot 3 Mill slot
2 Louvered shutter 4 Key punched5 Gauzed wrapped
6 Wire wrapped
7 Torch cut8 Saw cut
9 Drilled holes
10 Other (specify)

11 None (open hole)

SCREEN-PERFORATED INTERVALS: From 35 ft. to 75 ft. From ft. to ft. From ft. to ft.

GRAVEL PACK INTERVALS: From ft. to ft. From ft. to ft. From ft. to ft.

From ft. to ft. From ft. to ft. From ft. to ft.

6 GROUT MATERIAL: 1 Neat cement 2 Cement grout 3 Bentonite 4 Other

Grout Intervals: From 0 ft. to 20 ft. From ft. to ft. From ft. to ft. From ft. to ft.

What is the nearest source of possible contamination:

1 Septic tank 4 Lateral lines
2 Sewer lines 5 Cess pool
3 Watertight sewer lines 6 Seepage pit7 Pit privy 10 Livestock pens
8 Sewage lagoon 11 Fuel storage
9 Feedyard 12 Fertilizer storage
13 Insecticide storage

How many feet? 150

Direction from well?

5

FROM TO LITHOLOGIC LOG FROM TO PLUGGING INTERVALS

0 4
4 15
15 75Soil
Clay
Shale & Limestone

7 CONTRACTOR'S OR LANDOWNER'S CERTIFICATION: This water well was 1 constructed, (2) reconstructed, or (3) plugged under my jurisdiction and was completed on (mo/day/year) 6/18/93 and this record is true to the best of my knowledge and belief. Kansas

Water Well Contractor's License No. 251 This Water Well Record was completed on (mo/day/yr) 6/23/93
under the business name of Winter Well Drill by (signature) Charles Winter