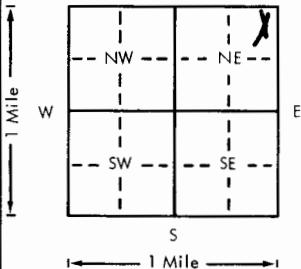


USE TYPEWRITER OR BALL  
POINT PEN-PRESS FIRMLY,  
PRINT CLEARLY.

WATER WELL RECORD  
KSA 82a-1201-1215

Kansas Department of Health and  
Environment-Division of Environment  
(Water well Contractors)  
Topeka, Kansas 66620

1. Location of well:	County <b>Butler</b>	Fraction <b>NE 1/4 NE 1/4 NE 1/4</b>	Section number <b>19</b>	Township number <b>27</b>	Range number <b>3E</b>	E/W	
2. Distance and direction from nearest town or city: Street address of well location if in city:	3. Owner of well: R.R. or street: City, state, zip code: <b>341 Lioba Andover, Kansas</b>			<b>Sam Minton 341 Lioba Andover, Kansas</b>			
4. Locate with "X" in section below:  	Sketch map:			6. Bore hole dia. <b>11</b> in. Completion date <b>3-29-78</b> Well depth <b>75</b> ft.			
5. Type and color of material	From	To	7. <input checked="" type="checkbox"/> Cable tool <input type="checkbox"/> Rotary <input type="checkbox"/> Driven <input type="checkbox"/> Dug <input type="checkbox"/> Hollow rod <input type="checkbox"/> Jetted <input type="checkbox"/> Bored <input type="checkbox"/> Reverse rotary				
Topsoil	<b>0</b>	<b>3</b>	8. Use: <input type="checkbox"/> Domestic <input type="checkbox"/> Public supply <input type="checkbox"/> Industry <input type="checkbox"/> Irrigation <input type="checkbox"/> Air conditioning <input type="checkbox"/> Stock <input checked="" type="checkbox"/> Lawn <input type="checkbox"/> Oil field water <input type="checkbox"/> Other				
Clay	<b>3</b>	<b>10</b>	9. Casing: Material <b>styrene</b> Weight: Above or <b>below</b> Threaded <input type="checkbox"/> Welded <b>g1</b> Surface <b>12</b> in. RMP <b>X</b> PVC Weight <b>12</b> lbs./ft. Dia. <b>5</b> in. to <b>75</b> ft. depth Wall Thickness: inches or Dia. <b>5</b> in. to <b>75</b> ft. depth Gage No. <b>.200</b>				
Brown Shale	<b>10</b>	<b>75</b>	10. Screen: Manufacturer's name <b>Sunflower Plastic</b> Type <b>styrene</b> Dia. <b>5"</b> Slot/gauge <b>.06</b> Length <b>35</b> Set between <b>40</b> ft. and <b>75</b> ft. ft. and <b>75</b> ft. Gravel pack? <b>yes</b> size range of material <b>1/2-1 1/8"</b>				
			11. Static water level: <b>40</b> ft. below land surface Date <b>3-29-78</b>				
			12. Pumping level below land surfaces: ft. after hrs. pumping g.p.m. ft. after hrs. pumping g.p.m. Estimated maximum yield g.p.m.				
			13. Water sample submitted: Yes <input type="checkbox"/> No <input type="checkbox"/> Date				
			14. Well head completion: <b>12</b> capped <input type="checkbox"/> Pitless adapter <b>12</b> inches above grade				
			15. Well grouted? <b>yes</b> 1-2 fine sand mix With: <input type="checkbox"/> Neat cement <input type="checkbox"/> Bentonite <input type="checkbox"/> Concrete Depth: From <b>40"</b> ft. to <b>14</b> ft.				
			16. <b>See #19 Below</b> City ft. <b>30</b> Direction <b>So.</b> Type <b>Sewer</b> Well disinfected upon completion? <input checked="" type="checkbox"/> Yes <input type="checkbox"/> No				
			17. Pump: <input checked="" type="checkbox"/> Not installed Manufacturer's name Model number <b>HP</b> <b>Volts</b> Length of drop pipe ft. capacity g.p.m. Type: <input type="checkbox"/> Submersible <input type="checkbox"/> Turbine <input type="checkbox"/> Jet <input type="checkbox"/> Reciprocating <input type="checkbox"/> Centrifugal <input type="checkbox"/> Other				
18. Elevation:	(Use a second sheet if needed)			20. Water well contractor's certification: This well was drilled under my jurisdiction and this report is true to the best of my knowledge and belief. <b>Harp Well &amp; Pump</b> <b>236</b> Business name <b>Wichita, Kansas</b> License No. Address Signed <b>M. Arnold</b> Date <b>5-9-78</b> Authorized representative			
Topography: <input type="checkbox"/> Hill <input type="checkbox"/> Slope <input type="checkbox"/> Upland <input type="checkbox"/> Valley	19. Remarks: <b>Flat Ground</b> <b>From #16. PVC watertight Sewer Line.</b>						