

WATER WELL RECORD

Form WWC-5

KSA 82a-1212

1 LOCATION OF WATER WELL:		Fraction NW $\frac{1}{4}$ NE $\frac{1}{4}$ NE $\frac{1}{4}$	Section Number 19	Township Number T 27 S	Range Number R 3E
---------------------------	--	--	----------------------	---------------------------	----------------------


County: Butler

Distance and direction from nearest town or city street address of well if located within city?

152 Lioba Andover, Ks.

2 WATER WELL OWNER:		Roger Mead 152 Lioba Andover, Ks.		Board of Agriculture, Division of Water Resources Application Number:
---------------------	--	---	--	--

3 LOCATE WELL'S LOCATION WITH AN "X" IN SECTION BOX:		4 DEPTH OF COMPLETED WELL..... 90 ft. ELEVATION:.....	
--	--	---	--

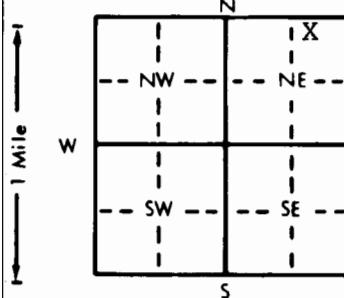

Depth(s) Groundwater Encountered 1. 30 ft. 2. ft. 3. ft.

WELL'S STATIC WATER LEVEL 30 ft. below land surface measured on mo/day/yr 7-14-89

Pump test data: Well water was ft. after hours pumping gpm

Est. Yield gpm: Well water was ft. after hours pumping gpm

Bore Hole Diameter 11 in. to 90 ft., and in. to ft.

WELL WATER TO BE USED AS: 5 Public water supply 8 Air conditioning 11 Injection well

1 Domestic 3 Feedlot 6 Oil field water supply 9 Dewatering 12 Other (Specify below)

2 Irrigation 4 Industrial 7 Lawn and garden only 10 Monitoring well

Was a chemical/bacteriological sample submitted to Department? Yes..... No..... X..... If yes, mo/day/yr sample was submitted

Water Well Disinfected? Yes X No

5 TYPE OF BLANK CASING USED: 5 Wrought iron 8 Concrete tile CASING JOINTS: Glued X..... Clamped.....

1 Steel 3 RMP (SR) 6 Asbestos-Cement 9 Other (specify below) Welded.....

2 PVC 4 ABS 7 Fiberglass Cer-Mac styrene SDR-26 Threaded.....

Blank casing diameter 5 in. to 30 ft., Dia. in. to ft., Dia. in. to ft.

Casing height above land surface 12 in., weight 1.59 lbs./ft. Wall thickness or gauge No. 203

TYPE OF SCREEN OR PERFORATION MATERIAL: 7 PVC 10 Asbestos-cement

1 Steel 3 Stainless steel 5 Fiberglass 8 RMP (SR) 11 Other (specify)

2 Brass 4 Galvanized steel 6 Concrete tile 9 ABS 12 None used (open hole)

SCREEN OR PERFORATION OPENINGS ARE: 5 Gauzed wrapped 8 Saw cut 11 None (open hole)

1 Continuous slot 3 Mill slot 6 Wire wrapped 9 Drilled holes

2 Louvered shutter 4 Key punched 7 Torch cut 10 Other (specify)

SCREEN-PERFORATED INTERVALS: From. 30 ft. to 95 ft., From. ft. to ft., From. ft. to ft.

From. ft. to ft., From. ft. to ft., From. ft. to ft.

GRAVEL PACK INTERVALS: From. 24 ft. to 95 ft., From. ft. to ft., From. ft. to ft.

From. ft. to ft., From. ft. to ft., From. ft. to ft.

6 GROUT MATERIAL: 1 Neat cement 2 Cement grout 3 Bentonite 4 Other

Grout Intervals: From. 4 ft. to 24 ft., From. ft. to ft., From. ft. to ft., From. ft. to ft.

What is the nearest source of possible contamination: 10 Livestock pens 14 Abandoned water well

1 Septic tank 4 Lateral lines 7 Pit privy 11 Fuel storage 15 Oil well/Gas well

2 Sewer lines 5 Cess pool 8 Sewage lagoon 12 Fertilizer storage 16 Other (specify below)

3 Watertight sewer lines 6 Seepage pit 9 Feedyard

Direction from well? South How many feet? 30

FROM TO LITHOLOGIC LOG FROM TO PLUGGING INTERVALS

0 3 topsoil

3 11 clay

11 51 brown shale

51 95 grey shale

7 CONTRACTOR'S OR LANDOWNER'S CERTIFICATION: This water well was (1) constructed, (2) reconstructed, or (3) plugged under my jurisdiction and was completed on (mo/day/year) 7-14-89 and this record is true to the best of my knowledge and belief. Kansas

Water Well Contractor's License No. 236 This Water Well Record was completed on (mo/day/yr) 7-20-89
under the business name of Harp Well and Pump Service, Inc. by (signature) *Mary Arnold*