

1 LOCATION OF WATER WELL:

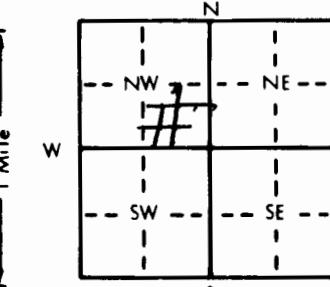
Fraction SW 1/4 SE 1/4 NW 1/4Section Number 19Township Number T 27 SRange Number R 30 ECounty: Batler
Distance and direction from nearest town or city street, address of well if located within city?In City of Andover

2 WATER WELL OWNER:

RR#, St. Address, Box #: John Baker, Andover KS 67002 Board of Agriculture, Division of Water ResourcesCity, State, ZIP Code: 303 Lexington

Application Number:

3 LOCATE WELL'S LOCATION WITH AN "X" IN SECTION BOX:

4 DEPTH OF COMPLETED WELL: 85 ft. ELEVATION:Depth(s) Groundwater Encountered 1. 55 ft. 2. ft. 3. ft.WELL'S STATIC WATER LEVEL 25 ft. below land surface measured on mo/day/yr

Pump test data: Well water was ft. after hours pumping gpm

Est. Yield 40 gpm; Well water was ft. after hours pumping gpmBore Hole Diameter 8 in. to ft., and in. to ft.

WELL WATER TO BE USED AS: 5 Public water supply 8 Air conditioning 11 Injection well

1 Domestic 3 Feedlot 6 Oil field water supply 9 Dewatering 12 Other (Specify below)

2 Irrigation 4 Industrial 7 Lawn and garden only 10 Monitoring well

Was a chemical/bacteriological sample submitted to Department? Yes No If yes, mo/day/yr sample was submitted

Water Well Disinfected? Yes No

5 TYPE OF BLANK CASING USED:

1 Steel 3 RMP (SR)
 2 PVC 4 ABS

5 Wrought iron

8 Concrete tile

CASING JOINTS: Glued Clamped6 Asbestos-Cement
7 Fiberglass

9 Other (specify below)

Welded

Threaded

Blank casing diameter 5 in. to 40 ft. Dia in. to ft. Dia in. to ft.Casing height above land surface 18 in., weight 160 lbs./ft. Wall thickness or gauge No. 1214

TYPE OF SCREEN OR PERFORATION MATERIAL:

1 Steel 3 Stainless steel
2 Brass 4 Galvanized steel5 Fiberglass
6 Concrete tile8 RMP (SR)
9 ABS10 Asbestos-cement
11 Other (specify)

12 None used (open hole)

SCREEN OR PERFORATION OPENINGS ARE:

1 Continuous slot 3 Mill slot
2 Louvered shutter 4 Key punched5 Gauzed wrapped
6 Wire wrapped

6 Saw cut

11 None (open hole)

7 Torch cut
85

9 Drilled holes

10 Other (specify)

SCREEN-PERFORATED INTERVALS: From 40 ft. to 85 ft., From ft. to ft.

From ft. to ft., From ft. to ft.

GRAVEL PACK INTERVALS: From ft. to ft., From ft. to ft.

From ft. to ft., From ft. to ft.

6 GROUT MATERIAL: 1 Neat cement 20 2 Cement grout

3 Bentonite

4 Other

Grout Intervals: From 0 ft. to 20 ft., From ft. to ft., From ft. to ft.

What is the nearest source of possible contamination:

1 Septic tank 4 Lateral lines
2 Sewer lines 5 Cess pool7 Pit privy
8 Sewage lagoon10 Livestock pens
11 Fuel storage 3 Watertight sewer lines 6 Seepage pit

9 Feedyard

12 Fertilizer storage
13 Insecticide storageDirection from well? NE How many feet? 1207 CONTRACTOR'S OR LANDOWNER'S CERTIFICATION: This water well was 1 constructed, (2) reconstructed, or (3) plugged under my jurisdiction and was completed on (mo/day/year) 5/2/92 and this record is true to the best of my knowledge and belief. KansasWater Well Contractor's License No. 251 This Water Well Record was completed on (mo/day/year) 5/2/92 by (signature) Charles Winterunder the business name of Winter Well Drill

INSTRUCTIONS: Use typewriter or ball point pen. PLEASE PRESS FIRMLY and PRINT clearly. Please fill in blanks, underline or circle the correct answers. Send top three copies to Kansas Department of Health and Environment, Bureau of Water, Topeka, Kansas 66620-0001. Telephone: 913-296-5545. Send one to WATER WELL OWNER and retain one for your records.

000152