

## WATER WELL RECORD Form WWC-5 KSA 82a-1212

1 LOCATION OF WATER WELL: County: Butler	Fraction SW 1/4 NW 1/4 SE 1/4	Section Number 20	Township Number T 27 S	Range Number R 3E E/W
---	----------------------------------	----------------------	---------------------------	--------------------------

Distance and direction from nearest town or city street address of well if located within city?

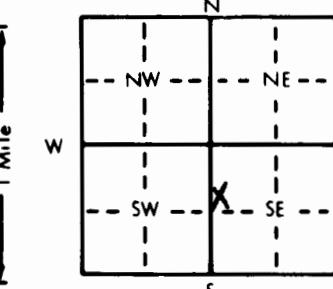
#8 Yorktown Andover, Ks.

2 WATER WELL OWNER: Duncan, KellyRR#, St. Address, Box #: #8 Yorktown

Board of Agriculture, Division of Water Resources

City, State, ZIP Code: Andover, Kansas

Application Number:

3 LOCATE WELL'S LOCATION WITH  
AN "X" IN SECTION BOX:4 DEPTH OF COMPLETED WELL: 118 ft. ELEVATION: \_\_\_\_\_

Depth(s) Groundwater Encountered 1. ft. 2. ft. 3. ft.

WELL'S STATIC WATER LEVEL: 51 ft. below land surface measured on mo/day/yr 9-6-91

Pump test data: Well water was ft. after hours pumping gpm

Est. Yield gpm: Well water was ft. after hours pumping gpm

Bore Hole Diameter: 11 in. to 118 ft. and in. to ft.

WELL WATER TO BE USED AS: 5 Public water supply 8 Air conditioning 11 Injection well

1 Domestic 3 Feedlot 6 Oil field water supply 9 Dewatering 12 Other (Specify below)

2 Irrigation 4 Industrial 7 Lawn and garden only 10 Monitoring well

Was a chemical/bacteriological sample submitted to Department? Yes  No  If yes, mo/day/yr sample was submittedWater Well Disinfected? Yes  No 

## 5 TYPE OF BLANK CASING USED:

1 Steel 3 RMP (SR)  
2 PVC 4 ABS

5 Wrought iron

8 Concrete tile

CASING JOINTS: Glued  Clamped 

9 Other (specify below)

Welded 

SDR-26

Threaded Blank casing diameter: 5 in. to 68 ft. Dia in. to ft. Dia in. to ft.Casing height above land surface: 12 in., weight 2.29 lbs./ft. Wall thickness or gauge No. .214

## TYPE OF SCREEN OR PERFORATION MATERIAL:

1 Steel 3 Stainless steel  
2 Brass 4 Galvanized steel

6 Asbestos-Cement

7 PVC

10 Asbestos-cement

7 Fiberglass

8 RMP (SR)

11 Other (specify)

6 Concrete tile

9 ABS

12 None used (open hole)

## SCREEN OR PERFORATION OPENINGS ARE:

1 Continuous slot 3 Mill slot  
2 Louvered shutter 4 Key punched

5 Gauzed wrapped

8 Saw cut

11 None (open hole)

6 Wire wrapped

9 Drilled holes

7 Torch cut

10 Other (specify)

SCREEN-PERFORATED INTERVALS: From 68 ft. to 118 ft. From ft. to ft. From ft. to ft.From 20 ft. to 118 ft. From ft. to ft. From ft. to ft.

GRAVEL PACK INTERVALS: From ft. to ft. From ft. to ft. From ft. to ft.

6 GROUT MATERIAL: 1 Neat cement 2 Cement grout 3 Bentonite 4 Other

Grout Intervals: From 3 ft. to 20 ft. From ft. to ft. From ft. to ft.

What is the nearest source of possible contamination: 10 Livestock pens 14 Abandoned water well

1 Septic tank 4 Lateral lines 7 Pit privy 11 Fuel storage 15 Oil well/Gas well

2 Sewer lines 5 Cess pool 8 Sewage lagoon 12 Fertilizer storage 16 Other (specify below)

3 Watertight sewer lines 6 Seepage pit 9 Feedyard 13 Insecticide storage

How many feet?

Direction from well?

FROM TO LITHOLOGIC LOG FROM TO PLUGGING INTERVALS

0 3 topsoil

3 15 clay

15 118 blue shell

7 CONTRACTOR'S OR LANDOWNER'S CERTIFICATION: This water well was (1) constructed, (2) reconstructed, or (3) plugged under my jurisdiction and was completed on (mo/day/year) 9-6-91 and this record is true to the best of my knowledge and belief. KansasWater Well Contractor's License No. 236 This Water Well Record was completed on (mo/day/yr) 12-31-91 by (signature) Mary Arnold  
under the business name of Harp Well and Pump Service, Inc.