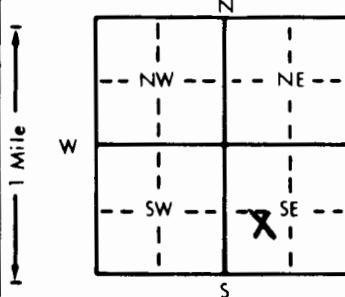


1 LOCATION OF WATER WELL: County: <u>Butler</u>	Fraction <u>NE 1/4</u>	SW <u>1/4</u>	SE <u>1/4</u>	Section Number <u>20</u>	T <u>27</u>	S	Range Number <u>R 3 EW</u>
--	------------------------	---------------	---------------	--------------------------	-------------	---	----------------------------

Distance and direction from nearest town or city street address of well if located within city?

1/2 mile EAST of Wichita2 WATER WELL OWNER: Janet White
RR#, St. Address, Box #: PO Box 300City, State, ZIP Code: Andover, KS 67002Board of Agriculture, Division of Water Resources
Application Number:

3 LOCATE WELL'S LOCATION WITH AN "X" IN SECTION BOX: N	4 DEPTH OF COMPLETED WELL: <u>100</u> ft. ELEVATION: _____
---	--

Depth(s) Groundwater Encountered 100 ft. 2. _____ ft. 3. _____ ft.WELL'S STATIC WATER LEVEL 32 ft. below land surface measured on mo/day/yr 5/10/92

Pump test data: Well water was _____ ft. after _____ hours pumping _____ gpm

Est. Yield 30 gpm: Well water was _____ ft. after _____ hours pumping _____ gpmBore Hole Diameter 10 in. to _____ ft., and _____ in. to _____ ft.

WELL WATER TO BE USED AS: 5 Public water supply 8 Air conditioning 11 Injection well

1 Domestic 3 Feedlot 6 Oil field water supply 9 Dewatering 12 Other (Specify below)

2 Irrigation 4 Industrial 7 Lawn and garden only 10 Monitoring well

Was a chemical/bacteriological sample submitted to Department? Yes _____ No _____ If yes, mo/day/yr sample was submitted _____ Water Well Disinfected? Yes _____ No _____

5 TYPE OF BLANK CASING USED: 1 Steel <u>PVC</u> 3 RMP (SR) 5 Wrought iron 8 Concrete tile Casing joints: Glued _____ Clamped _____	6 Asbestos-Cement 9 Other (specify below) Welded _____
---	--

Blank casing diameter 5 in. to _____ ft., Dia 160 in. to _____ ft., Dia _____ in. to _____ ft.Casing height above land surface 12 in., weight 160 lbs./ft. Wall thickness or gauge No. _____TYPE OF SCREEN OR PERFORATION MATERIAL:
1 Steel 3 Stainless steel 5 Fiberglass 8 RMP (SR) 10 Asbestos-cement

2 Brass 4 Galvanized steel 6 Concrete tile 9 ABS 11 Other (specify) _____

SCREEN OR PERFORATION OPENINGS ARE:
1 Continuous slot 3 Mill slot 5 Gauzed wrapped 6 Wire wrapped 8 Saw cut 11 None (open hole)

2 Louvered shutter 4 Key punched 7 Torch cut 9 Drilled holes 12 None used (open hole)

SCREEN-PERFORATED INTERVALS: From 80 ft. to 100 ft., From _____ ft. to _____ ft. From _____ ft. to _____ ft.

From _____ ft. to _____ ft., From _____ ft. to _____ ft. From _____ ft. to _____ ft.

GRAVEL PACK INTERVALS: From 20 ft. to 100 ft., From _____ ft. to _____ ft., From _____ ft. to _____ ft.

From _____ ft. to _____ ft., From _____ ft. to _____ ft. From _____ ft. to _____ ft.

6 GROUT MATERIAL: 1 Neat cement 2 Cement grout 3 <u>Bentonite</u> 4 Other _____	5 _____ ft. to _____ ft., From _____ ft. to _____ ft. From _____ ft. to _____ ft.
---	---

Grout Intervals: From 3 ft. to 20 ft., From _____ ft. to _____ ft., From _____ ft. to _____ ft.

What is the nearest source of possible contamination: 10 Livestock pens 14 Abandoned water well

1 Septic tank 4 lateral lines 7 Pit privy 11 Fuel storage 15 Oil well/Gas well

2 Sewer lines 5 Cess pool 8 Sewage lagoon 12 Fertilizer storage 16 Other (specify below)

3 Watertight sewer lines 6 Seepage pit 9 Feedyard 13 Insecticide storage

Direction from well? down slope How many feet? 50+

LITHOLOGIC LOG FROM TO PLUGGING INTERVALS

FROM	TO	LITHOLOGIC LOG	FROM	TO	PLUGGING INTERVALS
0	2	earth			
2	6	green shale			
6	24	grey shale			
24	32	red bed			
32	45	yellow clay			
43	60	shale			
60	78	shaly lime			
78	100	yellow lime			

7 CONTRACTOR'S OR LANDOWNER'S CERTIFICATION: This water well was (1) constructed, (2) reconstructed, or (3) plugged under my jurisdiction and was completed on (mo/day/year) 5/10/92 and this record is true to the best of my knowledge and belief. KansasWater Well Contractor's License No. 493 This Water Well Record was completed on (mo/day/yr) _____ by (signature) Jerry Rissman
under the business name of Rissman Well Drilling