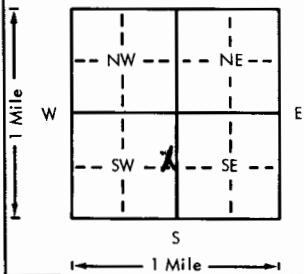


USE TYPEWRITER OR BALL
POINT PEN-PRESS FIRMLY,
PRINT CLEARLY.

WATER WELL RECORD
KSA 82a-1201-1215

Kansas Department of Health and
Environment-Division of Environment
(Water well Contractors)
Topeka, Kansas 66620

1. Location of well:	County Butler	Fraction SE 1/4 NE 1/4 SW 1/4	Section number 20	Township number T 27 S	Range number R 3E E/W		
2. Distance and direction from nearest town or city: Street address of well location if in city:	1/2 East of Andover Road 1/4 north of kellogg.		3. Owner of well: R.R. or street: City, state, zip code:	Richard Larson 5400 East 21st Street, Apt #717 Wichita, Kansas			
4. Locate with "X" in section below:	Sketch map:  Andover, Kansas		6. Bore hole dia. <u>11</u> in. Completion date <u>7-18-77</u> Well depth <u>65</u> ft.				
			7. <input checked="" type="checkbox"/> Cable tool <input type="checkbox"/> Rotary <input type="checkbox"/> Driven <input type="checkbox"/> Dug <input type="checkbox"/> Hollow rod <input type="checkbox"/> Jetted <input type="checkbox"/> Bored <input type="checkbox"/> Reverse rotary				
			8. Use: <input checked="" type="checkbox"/> Domestic <input type="checkbox"/> Public supply <input type="checkbox"/> Industry <input type="checkbox"/> Irrigation <input type="checkbox"/> Air conditioning <input type="checkbox"/> Stock <input type="checkbox"/> Lawn <input type="checkbox"/> Oil field water <input type="checkbox"/> Other				
			9. Casing: Material <input checked="" type="checkbox"/> styrene <input type="checkbox"/> concrete height: Above or below Threaded <input type="checkbox"/> Welded <u>81</u> Surface <u>12</u> in. RMP <input checked="" type="checkbox"/> PVC <input type="checkbox"/> Weight <input type="checkbox"/> lbs./ft. Dia <u>5</u> in. to <u>65</u> ft. depth Wall Thickness: inches or Dia. <input type="checkbox"/> in. to <input type="checkbox"/> ft. depth gage No. <u>200</u>				
5. Type and color of material			From	To	10. Screen: Manufacturer's name <u>Sunflower Plastic</u>		
Topsoil			0	3	Type <input checked="" type="checkbox"/> styrene Dia. <u>5"</u> Slot/gauge <u>.06</u> Length <u>37</u> Set between <u>28</u> ft. and <u>65</u> ft. ft. and <u>65</u> ft. Gravel pack? <input checked="" type="checkbox"/> YES Size range of material <u>1/4-1/8"</u>		
Brown Clay			3	8	11. Static water level: <u>27</u> ft. below land surface Date <u>7-18-77</u>		
Light Tan Clay			8	18	12. Pumping level below land surfaces: <input type="checkbox"/> ft. after <input type="checkbox"/> hrs. pumping <input type="checkbox"/> g.p.m. <input type="checkbox"/> ft. after <input type="checkbox"/> hrs. pumping <input type="checkbox"/> g.p.m. Estimated maximum yield <input type="checkbox"/> g.p.m.		
Light Tan Shale			18	25	13. Water sample submitted: <input type="checkbox"/> Yes <input type="checkbox"/> No Date <input type="checkbox"/>		
Blue Shale			25	65	14. Well head completion: <input type="checkbox"/> capped <input type="checkbox"/> Pitless adapter <u>12</u> inches above grade		
					15. Well grouted? <input checked="" type="checkbox"/> YES 1-2 fine sand mix With: <input type="checkbox"/> Neat cement <input type="checkbox"/> Bentonite <input checked="" type="checkbox"/> Concrete Depth: From <u>40"</u> ft. to <u>14</u> ft.		
					16. Nearest source of possible contamination: ft. <input type="checkbox"/> Direction <input type="checkbox"/> Type <input type="checkbox"/> NONE Well disinfected upon completion? <input checked="" type="checkbox"/> Yes <input type="checkbox"/> No		
					17. Pump: <input checked="" type="checkbox"/> Not installed Manufacturer's name <input type="checkbox"/> Model number <input type="checkbox"/> HP <input type="checkbox"/> Volts <input type="checkbox"/> Length of drop pipe <input type="checkbox"/> ft. capacity <input type="checkbox"/> g.p.m. Type: <input type="checkbox"/> Submersible <input type="checkbox"/> Turbine <input type="checkbox"/> Jet <input type="checkbox"/> Reciprocating <input type="checkbox"/> Centrifugal <input type="checkbox"/> Other		
(Use a second sheet if needed)					18. Elevation: Topography: <input type="checkbox"/> Hill <input type="checkbox"/> Slope <input type="checkbox"/> Upland <input type="checkbox"/> Valley	19. Remarks: Flat Ground Septic system not installed at this time. No apparent source for contamination.	20. Water well contractor's certification: This well was drilled under my jurisdiction and this report is true to the best of my knowledge and belief. <u>Harp Well & Pump</u> <u>236</u> Business name <u>Wichita, Kansas</u> License No. Address <u>Mr. Arnold</u> Signed <u>Mr. Arnold</u> Date <u>10-15-77</u> Authorized representative <u>10-15-77</u>