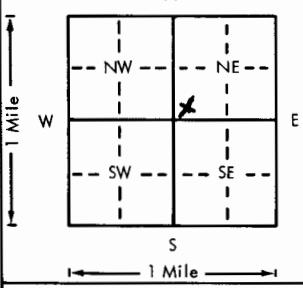


USE TYPEWRITER OR BALL  
POINT PEN-PRESS FIRMLY,  
PRINT CLEARLY.

WATER WELL RECORD  
KSA 82a-1201-1215

Kansas Department of Health and  
Environment-Division of Environment  
(Water well Contractors)  
Topeka, Kansas 66620

1. Location of well:	County <b>Butler</b>	Fraction <b>SE 1/4 SW 1/4 NE 1/4</b>	Section number <b>20</b>	Township number <b>T 27 S R</b>	Range number <b>3E/W</b>	
2. Distance and direction from nearest town or city: Street address of well location if in city:	2nd lot north of Betsy R.R. or street: <b>Ross Lane on the east</b>				3. Owner of well: <b>Richard Vaivada</b>	
4. Locate with "X" in section below:  	Sketch map: <b>side of the Monticello</b> <b>Andover, Kansas</b>				6. Bore hole dia. <b>11</b> in. Completion date <b>10-6-77</b> Well depth <b>65</b> ft.	
5. Type and color of material	From	To	7. <input checked="" type="checkbox"/> Cable tool <input type="checkbox"/> Rotary <input type="checkbox"/> Driven <input type="checkbox"/> Dug <input type="checkbox"/> Hollow rod <input type="checkbox"/> Jetted <input type="checkbox"/> Bored <input type="checkbox"/> Reverse rotary			
Topsoil	0	3	8. Use: <input checked="" type="checkbox"/> Domestic <input type="checkbox"/> Public supply <input type="checkbox"/> Industry <input type="checkbox"/> Irrigation <input type="checkbox"/> Air conditioning <input type="checkbox"/> Stock <input type="checkbox"/> Lawn <input type="checkbox"/> Oil field water <input type="checkbox"/> Other			
Clay	3	8	9. Casing: Material <input checked="" type="checkbox"/> styrene <input type="checkbox"/> Threaded <input type="checkbox"/> Welded <b>g1</b> Surface <b>12</b> in. RMP <input checked="" type="checkbox"/> PVC Weight <b>100</b> lbs./ft. Dia. <b>5</b> in. to <b>65</b> ft. depth Wall Thickness: inches or Dia. <b>5</b> in. to <b>65</b> ft. depth Gauge No. <b>200</b>			
Brown Shale	8	25	10. Screen: Manufacturer's name <b>Sunflower Plastic</b> Type <b>styrene</b> Dia. <b>5"</b> Slot/gauge <b>1/1.06</b> Length <b>45'</b> Set between <b>20</b> ft. and <b>65</b> ft. Gravel pack? <b>yes</b> Size range of material <b>1/4-17/8"</b>			
Gray Shale	25	65	11. Static water level: <b>17</b> ft. below land surface Date <b>10-6-77</b>			
			12. Pumping level below land surfaces: <b>17</b> ft. after <b>hrs.</b> pumping <b>g.p.m.</b> <b>17</b> ft. after <b>hrs.</b> pumping <b>g.p.m.</b> Estimated maximum yield <b>g.p.m.</b>			
			13. Water sample submitted: <b>mo./day/yr.</b> Yes <b>no</b> Date <b>10-6-77</b>			
			14. Well head completion: <b>capped</b> <input checked="" type="checkbox"/> Pitless adapter <b>12</b> inches above grade			
			15. Well grouted? <b>yes</b> 1-2 fine sand mix With: <input type="checkbox"/> Neat cement <input type="checkbox"/> Bentonite <input checked="" type="checkbox"/> Concrete Depth: From <b>40</b> ft. to <b>14</b> ft.			
			16. Nearest source of possible contamination: <b>NONE</b> ft. <b>0</b> Direction <b>0</b> Type <b>0</b> Well disinfected upon completion? <b>X</b> Yes <b>no</b>			
			17. Pump: <input checked="" type="checkbox"/> Not installed Manufacturer's name <b>Harp Well &amp; Pump</b> Model number <b>236</b> HP <b>1/2</b> Volts <b>115</b> Length of drop pipe <b>0</b> ft. capacity <b>0</b> g.p.m. Type: <input type="checkbox"/> Submersible <b>Turbine</b> <input type="checkbox"/> Jet <b>Reciprocating</b> <input type="checkbox"/> Centrifugal <b>Other</b>			
18. Elevation:	19. Remarks:  <b>Flat Ground</b>  <b>Septic system not installed when the well was drilled.</b>  <b>No apparent source for contamination.</b>					20. Water well contractor's certification: This well was drilled under my jurisdiction and this report is true to the best of my knowledge and belief. <b>Harp Well &amp; Pump</b> <b>236</b> Business name <b>Wichita, Kansas</b> License No. <b>10-6-77</b> Address <b>220 S. 5th Street</b> Signed <b>M. Arnold</b> Date <b>10-6-77</b> Authorized representative <b>10-6-77</b>