

## 1 LOCATION OF WATER WELL:

Fraction

NW 1/4 SW 1/4 SE 1/4

Section Number

20

Township Number

T 27 S

Range Number

R 3 @ EW

County: **Butler** Distance and direction from nearest town or city street address of well if located within city

3264 Hatcher - Andover KS.

## 2 WATER WELL OWNER:

RR#, St. Address, Box # :


3264 Hatcher - Andover, KS

City, State, ZIP Code

Board of Agriculture, Division of Water Resources

Application Number:

## 3 LOCATE WELL'S LOCATION WITH AN "X" IN SECTION BOX:

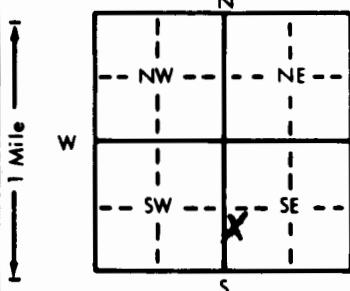

## 4 DEPTH OF COMPLETED WELL: 80 ft. ELEVATION: .....

Depth(s) Groundwater Encountered 1. 30 ft. 2. ft. 3. ft. ft.

WELL'S STATIC WATER LEVEL: 17 ft. below land surface measured on mo/day/yr 0-29-81

Pump test data: Well water was 30 ft. after 1/2 hours pumping gpm

Est. Yield 15.25 gpm: Well water was ft. after hours pumping gpm

Bore Hole Diameter: 11 in. to 80 ft. and. in. to ft.

WELL WATER TO BE USED AS: 5 Public water supply 8 Air conditioning 11 Injection well

1 Domestic 3 Feedlot 6 Oil field water supply 9 Dewatering 12 Other (Specify below)

2 Irrigation 4 Industrial 7 Lawn and garden only 10 Observation well

Was a chemical/bacteriological sample submitted to Department? Yes. No. If yes, mo/day/yr sample was submitted

Water Well Disinfected? Yes No

## 5 TYPE OF BLANK CASING USED:

1 Steel 3 RMP (SR) 5 Wrought iron 8 Concrete tile 10 Glued Clamped

2 PVC 4 ABS 6 Asbestos-Cement 9 Other (specify below) Welded

Blank casing diameter: 5 in. to 24 ft. Dia. in. to ft. Dia. in. to ft.

Casing height above land surface: 24 in. weight: 1.59 lbs./ft. Wall thickness or gauge No. 50P-26

## TYPE OF SCREEN OR PERFORATION MATERIAL:

1 Steel 3 Stainless steel 5 Fiberglass 8 RMP (SR) 10 Asbestos-cement

2 Brass 4 Galvanized steel 6 Concrete tile 9 ABS 11 Other (specify) .....

## SCREEN OR PERFORATION OPENINGS ARE:

1 Continuous slot 3 Mill slot 5 Gauzed wrapped 8 Saw cut 11 None (open hole)

2 Louvered shutter 4 Key punched 6 Wire wrapped 9 Drilled holes

7 Torch cut 10 Other (specify) .....

SCREEN-PERFORATED INTERVALS: From: 24 ft. to 80 ft. From: ft. to ft.

From: ft. to ft. From: ft. to ft.

GRAVEL PACK INTERVALS: From: 23 ft. to 80 ft. From: ft. to ft.

From: ft. to ft. From: ft. to ft.

## 6 GROUT MATERIAL: 1 Neat cement 2 Cement grout 3 Bentonite 4 Other .....

Grout Intervals: From: 3 ft. to 23 ft. From: ft. to ft. From: ft. to ft.

What is the nearest source of possible contamination:

1 Septic tank 4 Lateral lines 7 Pit privy 10 Livestock pens 14 Abandoned water well

2 Sewer lines 5 Cess pool 8 Sewage lagoon 11 Fuel storage 15 Oil well/Gas well

3 Watertight sewer lines 6 Seepage pit 9 Feedyard 12 Fertilizer storage 16 Other (specify below)

Direction from well? East How many feet? 40

FROM TO LITHOLOGIC LOG FROM TO LITHOLOGIC LOG

0 2 Top Soil.

2 24 Clay

24 80 Charcoal Shale

## 7 CONTRACTOR'S OR LANDOWNER'S CERTIFICATION: This water well was (1) constructed (2) reconstructed, or (3) plugged under my jurisdiction and was completed on (mo/day/year) 10-29-81 and this record is true to the best of my knowledge and belief. Kansas

Water Well Contractor's License No. 318 This Water Well Record was completed on (mo/day/yr) 10-29-81

under the business name of WENINGER DRILLING by (signature) Jerome Weninger

INSTRUCTIONS: Use typewriter or ball point pen. PLEASE PRESS FIRMLY and PRINT clearly. Please fill in blanks, underline or circle the correct answers. Send top three copies to Kansas Department of Health and Environment, Office of Oil Field and Environmental Geology, Regulation and Permitting Section, Topeka, Kansas 66620-7500, Telephone: 913-862-9360. Send one to WATER WELL OWNER and retain one for your records.