

WATER WELL RECORD Form WWC-5 KSA 82a-1212


1 LOCATION OF WATER WELL:	Fraction NW 1/4 NW 1/4 SE 1/4	Section Number 20	Township Number T 27 S	Range Number R 3 E EW
---------------------------	----------------------------------	----------------------	---------------------------	--------------------------

Distance and direction from nearest town or city street address of well if located within city?

335 McCandles, Andover, Ks.

2 WATER WELL OWNER: W.J. Combs	RR#, St. Address, Box #: #2 Williamsburg	Board of Agriculture, Division of Water Resources
City, State, ZIP Code: Andover, Ks.	Application Number:	

3 LOCATE WELL'S LOCATION WITH AN "X" IN SECTION BOX:	4 DEPTH OF COMPLETED WELL... 65 ft. ELEVATION:
--	--

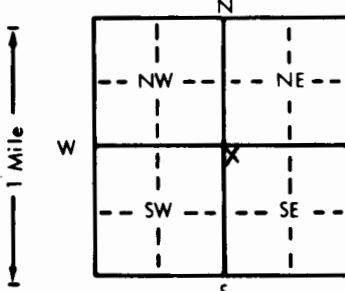

Depth(s) Groundwater Encountered 1... 15 ft. 2... ft. 3... ft.

WELL'S STATIC WATER LEVEL ... 15 ft. below land surface measured on mo/day/yr 3-10-82

Pump test data: Well water was ft. after hours pumping gpm

Est. Yield gpm: Well water was ft. after hours pumping gpm

Bore Hole Diameter... 11 in. to ft., and in. to ft.

WELL WATER TO BE USED AS: 5 Public water supply 8 Air conditioning 11 Injection well

1 Domestic 3 Feedlot 6 Oil field water supply 9 Dewatering 12 Other (Specify below)

2 Irrigation 4 Industrial 7 Lawn and garden only 10 Observation well

Was a chemical/bacteriological sample submitted to Department? Yes..... No X; If yes, mo/day/yr sample was submitted

Water Well Disinfected? Yes X No

5 TYPE OF BLANK CASING USED:	5 Wrought iron 8 Concrete tile CASING JOINTS: Glued X Clamped
1 Steel 3 RMP (SR)	6 Asbestos-Cement 9 Other (specify below) Welded
2 PVC 4 ABS	7 Fiberglass Threaded

Blank casing diameter 5 in. to 20 ft., Dia in. to Cer-Mac Styrene SDR-26 # Dia in. to ft.

Casing height above land surface 12 in., weight 1.59 lbs./ft. Wall thickness or gauge No. 203

TYPE OF SCREEN OR PERFORATION MATERIAL:	7 PVC 10 Asbestos-cement
1 Steel 3 Stainless steel 5 Fiberglass 8 RMP (SR)	11 Other (specify)
2 Brass 4 Galvanized steel 6 Concrete tile 9 ABS	12 None used (open hole)

SCREEN OR PERFORATION OPENINGS ARE:	5 Gauzed wrapped 8 Saw cut 11 None (open hole)
1 Continuous slot 3 Mill slot 6 Wire wrapped 9 Drilled holes	10 Other (specify)
2 Louvered shutter 4 Key punched 7 Torch cut	11 Other (specify)

SCREEN-PERFORATED INTERVALS: From 20 ft. to 65 ft., From ft. to ft.

From ft. to ft., From ft. to ft.

GRAVEL PACK INTERVALS: From 14 ft. to 65 ft., From ft. to ft.

From ft. to ft., From ft. to ft.

6 GROUT MATERIAL: 1 Neat cement 2 Cement grout 3 Bentonite 4 Other

Grout Intervals: From 4 ft. to 14 ft., From ft. to ft., From ft. to ft.

What is the nearest source of possible contamination: Septic System not Installed at This Time.

1 Septic tank 4 Lateral lines 7 Pit privy 10 Livestock pens	14 Abandoned water well
2 Sewer lines 5 Cess pool 8 Sewage lagoon 11 Fuel storage	15 Oil well/Gas well
3 Watertight sewer lines 6 Seepage pit 9 Feedyard 12 Fertilizer storage	16 Other (specify below)
	13 Insecticide storage
	NONE APPARENT

Direction from well? How many feet?

FROM	TO	LITHOLOGIC LOG	FROM	TO	LITHOLOGIC LOG
0	3	Clay			
3	18	Brown Clay			
18	65	Gray Shale			

7 CONTRACTOR'S OR LANDOWNER'S CERTIFICATION: This water well was (1) constructed, (2) reconstructed, or (3) plugged under my jurisdiction and was completed on (mo/day/year) 3-10-82 and this record is true to the best of my knowledge and belief. Kansas

Water Well Contractor's License No. 236 This Water Well Record was completed on (mo/day/yr) 5-7-82 by (signature) *M. Ainsel* under the business name of Harp Well & Pump Serv., Inc.

INSTRUCTIONS: Use typewriter or ball point pen, PLEASE PRESS FIRMLY and PRINT clearly. Please fill in blanks, underline or circle the correct answers. Send top three copies to Kansas Department of Health and Environment, Division of Environment, Environmental Geology Section, Topeka, KS 66620. Send one to WATER WELL OWNER and retain one for your records.