

1 LOCATION OF WATER WELL:	Fraction <u>NE 1/4 NW 1/4 SE 1/4</u>	Section Number <u>20</u>	Township Number <u>T 27 S</u>	Range Number <u>R 3 NW</u>
---------------------------	--------------------------------------	--------------------------	-------------------------------	----------------------------

County: Benton

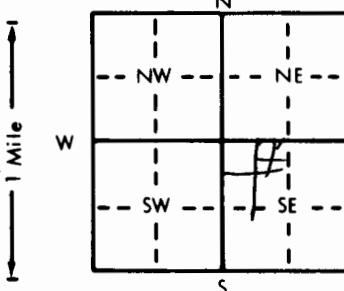
Distance and direction from nearest town or city street address of well if located within city?

7 mile west of Augusta

2 WATER WELL OWNER:	<u>Kenneth Crook</u>	69230 Andover	Board of Agriculture, Division of Water Resources
RR#, St. Address, Box #	<u>301 S McCandless</u>		
City, State, ZIP Code			

Application Number:

3 LOCATE WELL'S LOCATION WITH AN "X" IN SECTION BOX:	4 DEPTH OF COMPLETED WELL <u>85</u> ft. ELEVATION:
--	--

Depth(s) Groundwater Encountered 155 ft. 2. ft. 3. ft.WELL'S STATIC WATER LEVEL 35 ft. below land surface measured on mo/day/yr

Pump test data: Well water was ft. after hours pumping gpm

Est. Yield 2.5 gpm: Well water was ft. after hours pumping gpmBore Hole Diameter 8.5 in. to ft. and in. to ft.

WELL WATER TO BE USED AS: 5 Public water supply 8 Air conditioning 11 Injection well

1 Domestic 3 Feedlot 6 Oil field water supply 9 Dewatering 12 Other (Specify below)

2 Irrigation 4 Industrial 7 Lawn and garden only 10 Observation well

Was a chemical/bacteriological sample submitted to Department? Yes No; If yes, mo/day/yr sample was submittedWater Well Disinfected? Yes No

5 TYPE OF BLANK CASING USED:	5 Wrought iron	8 Concrete tile	CASING JOINTS: Glued <input checked="" type="checkbox"/> Clamped
------------------------------	----------------	-----------------	--

1 Steel 3 RMP (SR)2 PVC 4 ABSBlank casing diameter 3 in. to 85 ft., Dia. in. to ft., Dia. in. to ft.Casing height above land surface 18 in., weight 200 lbs./ft. Wall thickness or gauge No. 2.14

TYPE OF SCREEN OR PERFORATION MATERIAL:

1 Steel 3 Stainless steel 5 Fiberglass

2 Brass 4 Galvanized steel 6 Concrete tile

7 Fiberglass

7 PVC 10 Asbestos-cement

8 RMP (SR) 11 Other (specify)

9 ABS 12 None used (open hole)

SCREEN OR PERFORATION OPENINGS ARE:

1 Continuous slot 3 Mill slot 5 Gauzed wrapped

6 Wire wrapped

2 Louvered shutter 4 Key punched 7 Torch cut

10 Saw cut 11 None (open hole)

9 Drilled holes

12 Other (specify)

SCREEN-PERFORATED INTERVALS: From 45 ft. to 65 ft., From ft. to ft.

From ft. to ft., From ft. to ft.

GRAVEL PACK INTERVALS: From None ft. to ft., From ft. to ft.

From ft. to ft., From ft. to ft.

6 GROUT MATERIAL: 1 Neat cement 2 Cement grout 3 Bentonite 4 Other

Grout Intervals: From 3 ft. to 13 ft., From ft. to ft., From ft. to ft.

What is the nearest source of possible contamination:

1 Septic tank 4 Lateral lines 7 Pit privy

2 Sewer lines 5 Cess pool 8 Sewage lagoon

3 Watertight sewer lines 6 Seepage pit 9 Feedyard

10 Livestock pens 14 Abandoned water well

11 Fuel storage 15 Oil well/Gas well

12 Fertilizer storage 16 Other (specify below)

13 Insecticide storage

How many feet? 150Direction from well? E

FROM TO LITHOLOGIC LOG FROM TO LITHOLOGIC LOG

0	3	SOIL	FROM	TO	LITHOLOGIC LOG
---	---	------	------	----	----------------

3	15	CLAY	FROM	TO	LITHOLOGIC LOG
---	----	------	------	----	----------------

15	29	29 SHALE	FROM	TO	LITHOLOGIC LOG
----	----	----------	------	----	----------------

29	85	LIME	FROM	TO	LITHOLOGIC LOG
----	----	------	------	----	----------------

7 CONTRACTOR'S OR LANDOWNER'S CERTIFICATION: This water well was 1 constructed, 2 reconstructed, or 3 plugged under my jurisdiction and was completed on (mo/day/year) 5/1/81 and this record is true to the best of my knowledge and belief. KansasWater Well Contractor's License No. 257 This Water Well Record was completed on (mo/day/yr) 6/15/81under the business name of Winter Well Drill by (signature) Charles Winter

INSTRUCTIONS: Use typewriter or ball point pen, PLEASE PRESS FIRMLY and PRINT clearly. Please fill in blanks, underline or circle the correct answers. Send top three copies to Kansas Department of Health and Environment, Division of Environment, Environmental Geology Section, Topeka, KS 66620. Send one to WATER WELL OWNER and retain one for your records.