

WATER WELL RECORD

Form WWC-5

KSA 82a-1212

1 LOCATION OF WATER WELL:		Fraction NW 1/4 NW 1/4 SE 1/4	Section Number 20	Township Number T 27 S	Range Number R 3 E E/W
---------------------------	--	--	----------------------	---------------------------	---------------------------


County: BUTLER

Distance and direction from nearest town or city street address of well if located within city?

339 McCandles, Andover, Ks.

2 WATER WELL OWNER:		W.J. Combs	Board of Agriculture, Division of Water Resources		
RR#, St. Address, Box # :		#2 Williamsburg	Application Number:		
City, State, ZIP Code		Andover, Ks.			

3 LOCATE WELL'S LOCATION WITH AN "X" IN SECTION BOX:		4 DEPTH OF COMPLETED WELL..... 60..... ft. ELEVATION:			
--	--	---	--	--	--

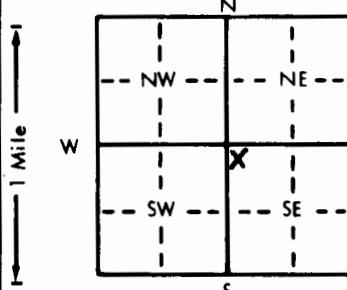

Depth(s) Groundwater Encountered 1..... 18..... ft. 2..... ft. 3..... ft.

WELL'S STATIC WATER LEVEL..... 18..... ft. below land surface measured on mo/day/yr 3-10-82

Pump test data: Well water was ft. after hours pumping gpm

Est. Yield gpm: Well water was ft. after hours pumping gpm

Bore Hole Diameter..... 11..... in. to ft., and in. to ft.

WELL WATER TO BE USED AS: 5 Public water supply 8 Air conditioning 11 Injection well

1 Domestic 3 Feedlot 6 Oil field water supply 9 Dewatering 12 Other (Specify below)

2 Irrigation 4 Industrial 7 Lawn and garden only 10 Observation well

Was a chemical/bacteriological sample submitted to Department? Yes..... No.... X.....; If yes, mo/day/yr sample was submitted

Water Well Disinfected? Yes X No

5 TYPE OF BLANK CASING USED:		5 Wrought iron	8 Concrete tile	CASING JOINTS: Glued ... X. Clamped.....
1 Steel	3 RMP (SR)	6 Asbestos-Cement	9 Other (specify below)	Welded.....
2 PVC	4 ABS	7 Fiberglass		Threaded.....

Blank casing diameter 5..... in. to 25..... ft., Dia..... in. to ft. Dia..... in. to ft.

Casing height above land surface..... 12..... in., weight..... 1.59..... lbs./ft. Wall thickness or gauge No. 203.....

TYPE OF SCREEN OR PERFORATION MATERIAL:		7 PVC	10 Asbestos-cement
1 Steel	3 Stainless steel	5 Fiberglass	11 Other (specify)
2 Brass	4 Galvanized steel	6 Concrete tile	12 None used (open hole)

SCREEN OR PERFORATION OPENINGS ARE: 5 Gauzed wrapped 8 Saw cut 11 None (open hole)

1 Continuous slot 3 Mill slot 6 Wire wrapped 9 Drilled holes

2 Louvered shutter 4 Key punched 7 Torch cut 10 Other (specify)

SCREEN-PERFORATED INTERVALS: From..... 25..... ft. to 60..... ft., From..... ft. to ft.

From..... ft. to ft., From..... ft. to ft.

GRAVEL PACK INTERVALS: From..... 14..... ft. to 60..... ft., From..... ft. to ft.

From..... ft. to ft., From..... ft. to ft.

6 GROUT MATERIAL:		1 Neat cement	2 Cement grout	3 Bentonite	4 Other
-------------------	--	---------------	----------------	-------------	---------------

Grout Intervals: From..... 4..... ft. to 14..... ft., From..... ft. to ft., From..... ft. to ft.

What is the nearest source of possible contamination: 10 Livestock pens 14 Abandoned water well

1 Septic tank 4 Lateral lines 7 Pit privy 11 Fuel storage 15 Oil well/Gas well

2 Sewer lines 5 Cess pool 8 Sewage lagoon 12 Fertilizer storage 16 Other (specify below)

3 Watertight sewer lines 6 Seepage pit 9 Feedyard 13 Insecticide storage

Direction from well? West How many feet? 75

FROM	TO	LITHOLOGIC LOG	FROM	TO	LITHOLOGIC LOG
------	----	----------------	------	----	----------------

0 3 Topsoil

3 27 Clay

27 60 Brown Shale

7 CONTRACTOR'S OR LANDOWNER'S CERTIFICATION: This water well was (1) constructed, (2) reconstructed, or (3) plugged under my jurisdiction and was completed on (mo/day/year) 3-10-82..... and this record is true to the best of my knowledge and belief. Kansas

Water Well Contractor's License No. 236..... This Water Well Record was completed on (mo/day/yr) 5-7-82.....

under the business name of Harp Well & Pump Serv., Inc., by (signature) M. Arnold

INSTRUCTIONS: Use typewriter or ball point pen, PLEASE PRESS FIRMLY and PRINT clearly. Please fill in blanks, underline or circle the correct answers. Send top three copies to Kansas Department of Health and Environment, Division of Environment, Environmental Geology Section, Topeka, KS 66620. Send one to WATER WELL OWNER and retain one for your records.