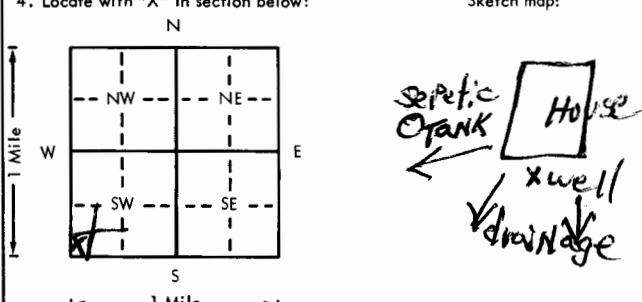


USE TYPEWRITER OR BALL
POINT PEN-PRESS FIRMLY,
PRINT CLEARLY.

WATER WELL RECORD
KSA 82a-1201-1215

Kansas Department of Health and
Environment-Division of Environment
(Water well Contractors)
Topeka, Kansas 66620

1. Location of well: County <u>Butler</u> Fraction <u>SW 1/4 SW 1/4 SW 1/4</u> Section number <u>23</u> Township number <u>T 27 S</u> Range number <u>R 3 E</u>	
2. Distance and direction from nearest town or city: <u>5 mi. W. of Augusta KS.</u> Street address of well location if in city: _____	
3. Owner of well: <u>Keith Meyer</u> R.R. or street: <u>R3 Box 120K</u> City, state, zip code: <u>Augusta KS</u>	
4. Locate with "X" in section below: Sketch map: 	
5. Type and color of material	
6. Bore hole dia. <u>9</u> in. Completion date <u>10-5-78</u> Well depth <u>70</u> ft.	
7. <input checked="" type="checkbox"/> Cable tool <input type="checkbox"/> Rotary <input type="checkbox"/> Driven <input type="checkbox"/> Dug <input type="checkbox"/> Hollow rod <input type="checkbox"/> Jetted <input type="checkbox"/> Bored <input type="checkbox"/> Reverse rotary	
8. Use: <input checked="" type="checkbox"/> Domestic <input type="checkbox"/> Public supply <input type="checkbox"/> Industry <input type="checkbox"/> Irrigation <input type="checkbox"/> Air conditioning <input type="checkbox"/> Stock <input type="checkbox"/> Lawn <input type="checkbox"/> Oil field water <input type="checkbox"/> Other	
9. Casing: Material <u>PLTS</u> Height: Above or below <u>16</u> in. Threaded <input type="checkbox"/> Welded <input checked="" type="checkbox"/> Surface <u>16</u> in. RMP <input checked="" type="checkbox"/> PVC <input type="checkbox"/> Weight <u>10</u> lbs./ft. Dia. <u>5</u> in. to <u>70</u> ft. depth Wall Thickness <u>10</u> inches or Dia. <u>5</u> in. to <u>70</u> ft. depth gage No. <u>200</u>	
10. Screen: Manufacturer's name <u>SUNFLOWER</u> <u>PLTS PIPE INC.</u> Type <u>RMP</u> Dia. <u>5</u> Slot/gauze <u>3/64</u> Length <u>10</u> Set between <u>60</u> ft. and <u>70</u> ft. Gravel pack? <input checked="" type="checkbox"/> Size range of material <u>1/4 - 3/4</u>	
11. Static water level: <u>41</u> ft. below land surface Date <u>10-5-78</u>	
12. Pumping level below land surfaces: <u>NA</u> ft. after <u>NA</u> hrs. pumping <u>NA</u> g.p.m. Estimated maximum yield <u>NA</u> g.p.m.	
13. Water sample submitted: <u>NA</u> mo./day/yr. Yes <input checked="" type="checkbox"/> No <input type="checkbox"/> Date <u>NA</u>	
14. Well head completion: <input checked="" type="checkbox"/> Pitless adapter <u>16</u> inches above grade	
15. Well grouted? <u>yes</u> With: <u>Neat cement</u> <input type="checkbox"/> Bentonite <input checked="" type="checkbox"/> Concrete <u>NA</u> Depth: From <u>14</u> ft. to <u>4</u> ft.	
16. Nearest source of possible contamination: <u>NA</u> ft. <u>NA</u> Direction <u>NA</u> Type <u>Sept</u> Well disinfected upon completion? <input checked="" type="checkbox"/> Yes <input type="checkbox"/> No	
17. Pump: <input checked="" type="checkbox"/> Not installed Manufacturer's name <u>NA</u> Model number <u>NA</u> HP <u>NA</u> Volts <u>NA</u> Length of drop pipe <u>NA</u> ft. capacity <u>NA</u> g.p.m. Type: <input type="checkbox"/> Submersible <input type="checkbox"/> Turbine <input type="checkbox"/> Jet <input type="checkbox"/> Reciprocating <input type="checkbox"/> Centrifugal <input type="checkbox"/> Other	
18. Elevation: Topography: <input checked="" type="checkbox"/> Hill <input checked="" type="checkbox"/> Slope <input type="checkbox"/> Upland <input type="checkbox"/> Valley	
19. Remarks: <u>owner will install concrete slab</u>	
20. Water well contractor's certification: This well was drilled under my jurisdiction and this report is true to the best of my knowledge and belief. <u>Brady Water Wells 363</u> Business name <u>NA</u> License No. <u>NA</u> Address <u>R3 Box 277A Douglass KS</u> Signed <u>Richard Brady</u> Date <u>10-6-78</u> Authorized representative	

Forward the white, blue and pink copies to the Department of Health and Environment

Form WWC-5