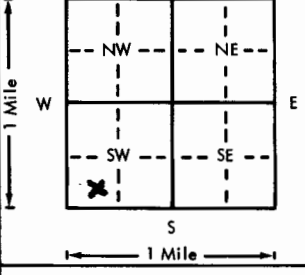


USE TYPEWRITER OR BALL
POINT PEN-PRESS FIRMLY,
PRINT CLEARLY.

WATER WELL RECORD
KSA 82a-1201-1215

Kansas Department of Health and
Environment-Division of Environment
(Water well Contractors)
Topeka, Kansas 66620

| | | | | | | | |
|--|--|--|---|--|--------------------------------|--|-----------|
| 1. Location of well: | | County Butler | Fraction SE 1/4 SW 1/4 SW 1/4 | Section number 23 | Township number T 27 | Range number S R 3 | EW |
| 2. Distance and direction from nearest town or city: 15 3/4 E | | | | 3. Owner of well: Robert Van Meter | | | |
| Street address of well location if in city: Andover | | | | R.R. or street: 4219 Deerfield | | | |
| | | | | City, state, zip code: Wichita Kans 67216 | | | |
| 4. Locate with "X" in section below: | | Sketch map: | | 6. Bore hole dia. 10 in. Completion date 6-7-77 | | | |
| N | | wheat field | | Well depth 100 ft. | | | |
|  | | well X HOUSE plan | | 7. <input checked="" type="checkbox"/> Cable tool <input type="checkbox"/> Rotary <input type="checkbox"/> Driven <input type="checkbox"/> Dug | | | |
| W | | Septic tank | | <input type="checkbox"/> Hollow rod <input type="checkbox"/> Jetted <input type="checkbox"/> Bored <input type="checkbox"/> Reverse rotary | | | |
| E | | | | 8. Use: <input checked="" type="checkbox"/> Domestic <input type="checkbox"/> Public supply <input type="checkbox"/> Industry | | | |
| S | | | | <input type="checkbox"/> Irrigation <input type="checkbox"/> Air conditioning <input type="checkbox"/> Stock | | | |
| 1 Mile | | | | <input type="checkbox"/> Lawn <input type="checkbox"/> Oil field water <input type="checkbox"/> Other | | | |
| | | | | 9. Casing: Material plb Height Above or below | | | |
| | | | | Threaded <input type="checkbox"/> Welded <input checked="" type="checkbox"/> Surface 15 in. | | | |
| | | | | RMP <input checked="" type="checkbox"/> PVC <input type="checkbox"/> Weight 175 lbs./ft. | | | |
| | | | | Dia. 6 in. to 80 ft. depth Wall Thickness: inches or | | | |
| | | | | Dia. 1/2 in. to 175 ft. depth gage No. 175 | | | |
| 5. Type and color of material | | From | | To | | 10. Screen: Manufacturer's name Y.L. | |
| Brown soil | | 0 | | 7 | | Type RMP Dia. 6 | |
| grey shale | | 7 | | 19 | | Slotted gauge 1/16 Length 20ft | |
| grey lime | | 19 | | 31 | | Set between 80 ft. and 100 ft. | |
| grey shale | | 31 | | 52 | | Gravel pack? no Size range of material | |
| grey lime | | 52 | | 58 | | 11. Static water level: 69 ft. below land surface Date 6-7-77 | |
| grey shale | | 58 | | 71 | | 12. Pumping level below land surfaces: | |
| grey lime | | 71 | | 91 | | ____ ft. after ____ hrs. pumping ____ g.p.m. | |
| water | | 91 | | 100 | | ____ ft. after ____ hrs. pumping ____ g.p.m. | |
| grey shale | | 91 | | 100 | | Estimated maximum yield 20+ g.p.m. | |
| | | | | | | 13. Water sample submitted: ____ mo./day/yr. | |
| | | | | | | ____ Yes <input checked="" type="checkbox"/> No Date | |
| | | | | | | 14. Well head completion: | |
| | | | | | | ____ Pitless adapter 18 Inches above grade | |
| | | | | | | 15. Well grouted? yes | |
| | | | | | | With: <input checked="" type="checkbox"/> Neat cement <input type="checkbox"/> Bentonite <input type="checkbox"/> Concrete | |
| | | | | | | Depth: From 0 ft. to 10 ft. | |
| | | | | | | 16. Nearest source of possible contamination: | |
| | | | | | | ft. ____ Direction ____ Type ____ | |
| | | | | | | Well disinfected upon completion? yes Yes ____ No | |
| | | | | | | 17. Pump: <input checked="" type="checkbox"/> Not installed | |
| | | | | | | Manufacturer's name ____ | |
| | | | | | | Model number ____ HP ____ Volts ____ | |
| | | | | | | Length of drop pipe ____ ft. capacity ____ g.p.m. | |
| | | | | | | Type: | |
| | | | | | | <input type="checkbox"/> Submersible <input type="checkbox"/> Turbine | |
| | | | | | | <input type="checkbox"/> Jet <input type="checkbox"/> Reciprocating | |
| | | | | | | <input type="checkbox"/> Centrifugal <input type="checkbox"/> Other | |
| 18. Elevation: | | 19. Remarks: owner will put on slab | | 20. Water well contractor's certification: | | | |
| Topography: | | Robert Van Meter | | This well was drilled under my jurisdiction and this report | | | |
| <input type="checkbox"/> Hill | | | | is true to the best of my knowledge and belief. | | | |
| <input checked="" type="checkbox"/> Slope | | | | Wike well drilling 122 | | | |
| <input checked="" type="checkbox"/> Upland | | | | Business name Box 57 Augusta | | | |
| <input type="checkbox"/> Valley | | | | Address Rt 3 License No. 122 | | | |
| | | | | Signed Murray White Date 6-7-77 | | | |
| | | | | Authorized representative | | | |

Forward the white, blue and pink copies to the Department of Health and Environment

Form WWC-5