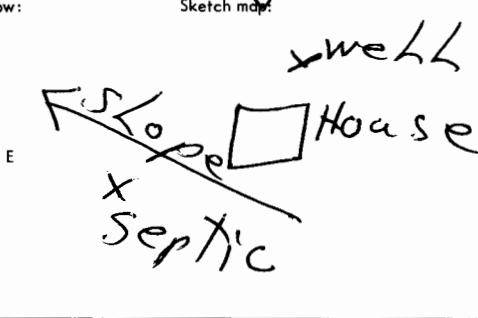


USE TYPEWRITER OR BALL
POINT PEN-PRESS FIRMLY,
PRINT CLEARLY.

WATER WELL RECORD
KSA 82a-1201-1215

Kansas Department of Health and
Environment-Division of Environment
(Water well Contractors)
Topeka, Kansas 66620

1. Location of well:	County <i>Batler</i>	Fraction <i>NW 1/4 NW 1/4 NW 1/4</i>	Section number <i>23</i>	Township number <i>T 27 S</i>	Range number <i>R 3 E/W</i>	
2. Distance and direction from nearest town or city:	<i>6 W</i>		3. Owner of well: R.R. or street: <i>Robert Lord</i>			
Street address of well location if in city:	<i>1 N Augusta</i>		City, state, zip code: <i>181 Augusta 67010</i>			
4. Locate with "X" in section below:	Sketch map: 					
5. Type and color of material	From	To				
	<i>0</i>	<i>5</i>				
	<i>5</i>	<i>15</i>				
	<i>15</i>	<i>35</i>				
	<i>35</i>	<i>50</i>				
	<i>50</i>	<i>60</i>				
	<i>60</i>	<i>75</i>				
	<i>75</i>	<i>85</i>				
	<i>85</i>	<i>100</i>				
(Use a second sheet if needed)						
18. Elevation:	19. Remarks: <i>Owner to install Cement Slab around Well Head</i>					20. Water well contractor's certification: This well was drilled under my jurisdiction and this report is true to the best of my knowledge and belief. <i>Winter Well Drill 25Y</i>
Topography: <input type="checkbox"/> Hill <input type="checkbox"/> Slope <input checked="" type="checkbox"/> Upland <input type="checkbox"/> Valley						Business name <i>R2 Box 3d Augusta</i>
						Address <i>181</i>
						Signed <i>Winter Well Drill 25Y</i>
						Authorized representative <i>Winter Well Drill 25Y</i>