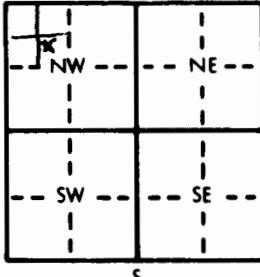
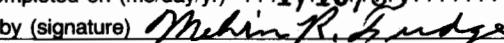


1 LOCATION OF WATER WELL:		Fraction County: Butler SE $\frac{1}{4}$ NW $\frac{1}{4}$ NW $\frac{1}{4}$	Section Number 23	Township Number T 27 S	Range Number R 3 NW
Distance and direction from nearest town or city street address of well if located within city? from Augusta Airport, North .9, E .2, South side of road					
2 WATER WELL OWNER: Kenneth W. Stuber		Board of Agriculture, Division of Water Resources Application Number:			
RR#, St. Address, Box #: R R 3					
City, State, ZIP Code: Augusta, Ks.					
3 LOCATE WELL'S LOCATION WITH AN "X" IN SECTION BOX:		4 DEPTH OF COMPLETED WELL. 67 $\frac{1}{2}$ ft. ELEVATION:			
		Depth(s) Groundwater Encountered 1. 35 ft. 2. 41 ft. 3. 66 $\frac{1}{2}$ ft.			
		WELL'S STATIC WATER LEVEL 41 ft. below land surface measured on mo/day/yr 9/17/82			
		Pump test data: Well water was ft. after hours pumping gpm			
		Est. Yield 1.5+ gpm: Well water was ft. after hours pumping gpm			
		Bore Hole Diameter 10 in. to 67 $\frac{1}{2}$ ft., and in. to ft.			
		WELL WATER TO BE USED AS: 5 Public water supply 8 Air conditioning 11 Injection well 1 Domestic 3 Feedlot 6 Oil field water supply 9 Dewatering 12 Other (Specify below) 2 Irrigation 4 Industrial 7 Lawn and garden only 10 Observation well			
		Was a chemical/bacteriological sample submitted to Department? Yes No If yes, mo/day/yr sample was submitted			
		Water Well Disinfected? Yes <input checked="" type="checkbox"/> No <input type="checkbox"/>			
5 TYPE OF BLANK CASING USED:		5 Wrought iron	8 Concrete tile	CASING JOINTS: Glued <input checked="" type="checkbox"/> Clamped	
1 Steel <input checked="" type="checkbox"/> RMP (SR)		6 Asbestos-Cement	9 Other (specify below)	Welded	
2 PVC <input type="checkbox"/> ABS		7 Fiberglass		Threaded	
Blank casing diameter 6 in. to 67 $\frac{1}{2}$ ft., Dia in. to ft., Dia in. to ft.					
Casing height above land surface 18 in., weight		lbs./ft. Wall thickness or gauge No. 200			
TYPE OF SCREEN OR PERFORATION MATERIAL:		7 PVC	10 Asbestos-cement		
1 Steel 3 Stainless steel		5 Fiberglass	7 RMP (SR)	11 Other (specify)	
2 Brass 4 Galvanized steel		6 Concrete tile	9 ABS	12 None used (open hole)	
SCREEN OR PERFORATION OPENINGS ARE:		5 Gauzed wrapped	8 Saw cut	11 None (open hole)	
1 Continuous slot 3 Mill slot		6 Wire wrapped	9 Drilled holes		
2 Louvered shutter 4 Key punched		7 Torch cut	10 Other (specify)		
SCREEN-PERFORATED INTERVALS: From 37 $\frac{1}{2}$ ft. to 67 $\frac{1}{2}$ ft., From ft. to ft.					
From ft. to ft., From ft. to ft.					
GRAVEL PACK INTERVALS: From 30 ft. to 67 $\frac{1}{2}$ ft., From ft. to ft.					
From ft. to ft., From ft. to ft.					
6 GROUT MATERIAL: <input checked="" type="checkbox"/> Neat cement 2 Cement grout 3 Bentonite 4 Other					
Grout Intervals: From 0 ft. to 10 ft., From ft. to ft., From ft. to ft.					
What is the nearest source of possible contamination:					
1 Septic tank <input checked="" type="checkbox"/> Lateral lines		7 Pit privy	10 Livestock pens	14 Abandoned water well	
2 Sewer lines 5 Cess pool		8 Sewage lagoon	11 Fuel storage	15 Oil well/Gas well	
3 Watertight sewer lines 6 Seepage pit		9 Feedyard	12 Fertilizer storage	16 Other (specify below)	
13 Insecticide storage to be completed in					
How many feet? compliance with Bu. Co.					
FROM	TO	LITHOLOGIC LOG	FROM	TO	LITHOLOGIC LOG permit
0	3	top soil			
3	12	reddish brown shale			
12	29	yellow gray shale			
29	35	yellow gray shale with interbedded limestone			
35	36	brownish gray shale			
36	41	yellow gray shale with interbedded yellow gray limestone			
41	51	gray limestone			
51	55	yellow gray shale			
55	61	blue gray shale			
61	65	blue gray fissile shale			
65	66 $\frac{1}{2}$	blue gray shale (clay)			
66 $\frac{1}{2}$	67 $\frac{1}{2}$	blue gray shale with interbedded limestone			
7 CONTRACTOR'S OR LANDOWNER'S CERTIFICATION: This water well was (1) constructed, (2) reconstructed, or (3) plugged under my jurisdiction and was completed on (mo/day/year) May 1978 and this record is true to the best of my knowledge and belief. Kansas Water Well Contractor's License No. 279 This Water Well Record was completed on (mo/day/yr) 1/10/83 under the business name of Fudge Drilling by (signature) 					
INSTRUCTIONS: Use typewriter or ball point pen, PLEASE PRESS FIRMLY and PRINT clearly. Please fill in blanks, underline or circle the correct answers. Send top three copies to Kansas Department of Health and Environment, Division of Environment, Environmental Geology Section, Topeka, KS 66620. Send one to WATER WELL OWNER and retain one for your records.					