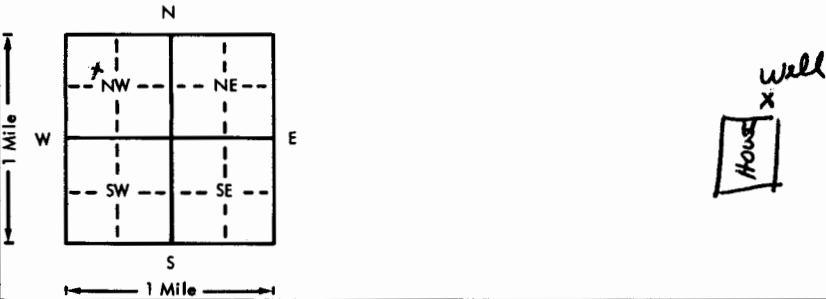
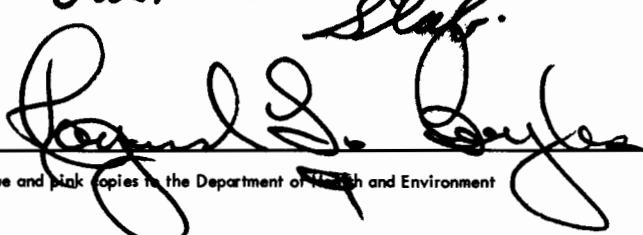


USE TYPEWRITER OR BALL
POINT PEN-PRESS FIRMLY,
PRINT CLEARLY.

WATER WELL RECORD
KSA 82a-1201-1215

Kansas Department of Health and
Environment-Division of Environment
(Water well Contractors)
Topeka, Kansas 66620

| | | | | | |
|---|---|--|--|-----------------|--------------|
| 1. Location of well: | County | Fraction | Section number | Township number | Range number |
| | Butler | SE 1/4 NW 1/4 NW 1/4 | 23 | T 27 | S R 3 EW |
| 2. Distance and direction from nearest town or city: | 3 E + 1 1/2 S | 3. Owner of well: R.R. or street: City, state, zip code: | Ray Boyles 1733 Dollinger Wichita Kans | | |
| 4. Locate with "X" in section below: | Sketch map:  | | | | |
| 5. Type and color of material | From | To | | | |
| Brown Clay | 0 | 4 | | | |
| grey shale | 4 | 18 | | | |
| yellow lime | 18 | 42 | | | |
| Blue shale | 42 | 48 | | | |
| water | 48 | | | | |
| grey lime | 48 | 60 | | | |
| (Use a second sheet if needed) | | | | | |
| 18. Elevation: Topography: Hill Slope X Upland Valley | 19. Remarks: owner will put on slab.  | | | | |
| 20. Water well contractor's certification: This well was drilled under my jurisdiction and this report is true to the best of my knowledge and belief. Business name: <u>Wise well drilling 122</u> License No. <u>122</u> Address: <u>Route 3 Box 1231 Augusta</u> Signed <u>Murray Wise</u> Date <u>7-19-1976</u> Authorized representative <u>7-19-1976</u> | | | | | |