USE TYPEWRITER OR BALL POINT PEN-PRESS FIRMLY, PRINT CLEARLY.

WATER WELL RECORD
KSA 82a-1201-1215

Kansas Department of Health and Environment-Division of Environment
(Water well Contractors)
Topeka, Kansas 66620

1. Location of well:	County: Butler	Fraction: NE 1/4 NW 1/4 SW 1/4	Section number: 23	Township number: T 27 S	Range number: R 3 E/W

2. Distance and direction from nearest town or city: 6 W ½ N
Street address of well location if in city: Augusta

3. Owner of well: Larry Shackel Ford
R.R. or street: 844 Allen
City, state, zip code: Wichita Kan 67230

4. Locate with "X" in section below:

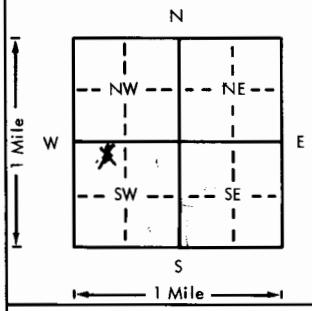

Sketch map:

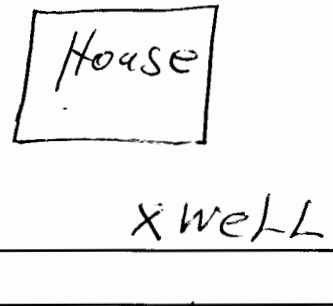

6. Bore hole dia. 8 in. Completion date 1/11/79
Well depth 100 ft.

7. X Cable tool __ Rotary __ Driven __ Dug
__ Hollow rod __ Jetted __ Bored __ Reverse rotary

8. Use: X Domestic __ Public supply __ Industry
__ Irrigation __ Air conditioning __ Stock
__ Lawn __ Oil field water __ Other

9. Casing: Material Plas
Threaded ___ Welded X
RMP X PVC ___
Dia. 6 in. to 100 ft. depth
Dia. ___ in. to ___ ft. depth
Height: Above or below Surface 18 in.
Weight 100 lbs./ft.
Wall Thickness: inches or gage No. .175

10. Screen: Manufacturer's name Sun Flower
Type 100 Dia. 6
Slot/gauze 1/46 Length 20
Set between 70 ft. and 90 ft.
___ ft. and ___ ft.
Gravel pack? N/A Size range of material ___

11. Static water level: 70 ft. below land surface Date 11/30/78 (mo./day/yr.)

12. Pumping level below land surfaces:
75 ft. after 1 hrs. pumping 50 g.p.m.
___ ft. after ___ hrs. pumping ___ g.p.m.
Estimated maximum yield 50 g.p.m.

13. Water sample submitted: X Yes __ No Date 1/11/79 (mo./day/yr.)

14. Well head completion:
__ Pitless adapter ___ Inches above grade

15. Well grouted? Yes
With: X Neat cement __ Bentonite __ Concrete
Depth: From 0 ft. to 10 ft.

16. Nearest source of possible contamination:
ft. 100 Direction NE Type Septic
X Well disinfected upon completion? X Yes __ No

17. Pump: __ Not installed
Manufacturer's name ___
Model number ___ HP ___ Volts ___
Length of drop pipe ___ ft. capacity ___ g.p.m.
Type:
__ Submersible __ Turbine
__ Jet __ Reciprocating
__ Centrifugal __ Other

5. Type and color of material	From	To
Soil	0	3
Rock	3	18
Shale	18	30
Lime	30	80
Shale	80	100

(Use a second sheet if needed)

18. Elevation:
Topography:
__ Hill
__ Slope
X Upland
__ Valley

19. Remarks: Owner To Install Slab of Concret around Well

20. Water well contractor's certification:
This well was drilled under my jurisdiction and this report is true to the best of my knowledge and belief.
Winter Well Drill 251
Business name License No.
Address P.O. Box 30 Augusta
Signed Charles W. Winter Date 1/29/79
Authorized representative

27 - 3 E 23 NE NW SW

Forward the white, blue and pink copies to the Department of Health and Environment

Form WWC-5

MI-1023