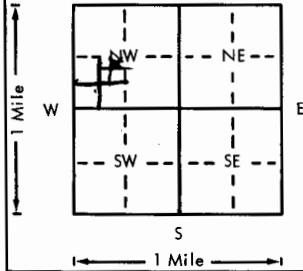


USE TYPEWRITER OR BALL
POINT PEN-PRESS FIRMLY,
PRINT CLEARLY.

WATER WELL RECORD
KSA 82a-1201-1215

Kansas Department of Health and
Environment-Division of Environment
(Water well Contractors)
Topeka, Kansas 66620

1. Location of well:	County Butler	Fraction NE 1/4 SW 1/4 NW 1/4	Section number 23	Township number T 27	Range number S 3
2. Distance and direction from nearest town or city:	3/4 SO 50' of		3. Owner of well: R.R. or street: Keith Meyer RJ Box 120K	City, state, zip code: Augusta KS	
4. Locate with "X" in section below:	Sketch map: 		6. Bore hole dia. 8-5 in. Completion date 4-17-79 Well depth 120 ft.		
			7. <input checked="" type="checkbox"/> Cable tool <input type="checkbox"/> Rotary <input type="checkbox"/> Driven <input type="checkbox"/> Dug <input type="checkbox"/> Hollow rod <input checked="" type="checkbox"/> Jetted <input type="checkbox"/> Bored <input type="checkbox"/> Reverse rotary		
			8. Use: <input checked="" type="checkbox"/> Domestic <input type="checkbox"/> Public supply <input type="checkbox"/> Industry <input type="checkbox"/> Irrigation <input type="checkbox"/> Air conditioning <input type="checkbox"/> Stock <input type="checkbox"/> Lawn <input type="checkbox"/> Oil field water <input type="checkbox"/> Other		
			9. Casing: Material PVC Height: Above 12 in. Threaded <input type="checkbox"/> Welded glue Surface 12 in. RMP X PVC Weight 120 lbs./ft. Dia: 5 in. to 120 ft. depth Wall Thickness: inches or Dia. 5 in. to 120 ft. depth gage No. 200		
5. Type and color of material	From	To	10. Screen: Manufacturer's name SUNFLOWER MFG Type RMP Dia. 5" Slot/gauze 264 Length 120 Set between 110 ft. and 120 ft. ft. and 120 ft. Gravel pack? yes Size range of material 8-32		
Fill Dirt	0	2	11. Static water level: 88 ft. below land surface Date 4-17-79		
Top soil	2	3	12. Pumping level below land surfaces: NA ft. after 0 hrs. pumping 0 g.p.m. ft. after 0 hrs. pumping 0 g.p.m. Estimated maximum yield 0 g.p.m.		
Clay Red	3	12	13. Water sample submitted: no Date 4-17-79 Yes <input checked="" type="checkbox"/> No <input type="checkbox"/>		
Clay yellow	12	16	14. Well head completion: Pitless adapter 12 inches above grade		
Shale light green	16	35	15. Well grouted? yes With: <input type="checkbox"/> Neat cement <input type="checkbox"/> Bentonite <input checked="" type="checkbox"/> Concrete Depth: From 14 ft. to 4 ft.		
clay yellow with limestone	35	48	16. Nearest source of possible contamination: septic ft. 65 Direction SW Type septic Well disinfected upon completion? yes Yes <input type="checkbox"/> No <input checked="" type="checkbox"/>		
Limestone yellow	48	55	17. Pump: <input checked="" type="checkbox"/> Not installed Manufacturer's name Brady Water Wells 363 Model number 52 Douglass KS HP 1/2 Volts 110 Length of drop pipe 0 ft. capacity 0 g.p.m. Type: <input type="checkbox"/> Submersible <input type="checkbox"/> Turbine <input type="checkbox"/> Jet <input type="checkbox"/> Reciprocating <input type="checkbox"/> Centrifugal <input type="checkbox"/> Other		
Shale blue gray	55	78	18. Elevation: 109 Topography: <input checked="" type="checkbox"/> Hill <input checked="" type="checkbox"/> Slope <input type="checkbox"/> Upland <input type="checkbox"/> Valley		
Shale gray brown	78	97	19. Remarks: OWNER WILL INSTALL CONCRETE SLAB		
Limestone yellow	97	109	20. Water well contractor's certification: This well was drilled under my jurisdiction and this report is true to the best of my knowledge and belief. Brady Water Wells 363 Business name 52 Douglass KS License No. 4-13-79 Address Richard Brady Date 4-13-79 Signed Richard Brady Authorized representative		