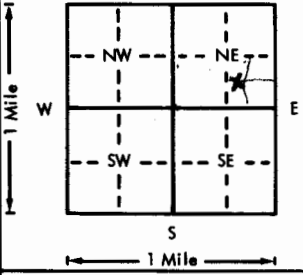


USE TYPEWRITER OR BALL
POINT PEN-PRESS FIRMLY,
PRINT CLEARLY.

WATER WELL RECORD
KSA 82a-1201-1215

Kansas Department of Health and
Environment-Division of Environment
(Water well Contractors)
Topeka, Kansas 66620

| | | | | | | |
|---|--|---|---|---|----------------------------------|---|
| 1. Location of well: | | County <u>Butler</u> | Fraction <u>SW 1/4 SE 1/4 NE 1/4</u> | Section number <u>23</u> | Township number <u>T 27 S</u> | Range number <u>R 3 E</u> |
| 2. Distance and direction from nearest town or city: Street address of well location if in city: | | <u>4 1/2 N</u> <u>Augusta Kans</u> | | 3. Owner of well: R.R. or street: City, state, zip code: | | |
| 4. Locate with "X" in section below: | | Sketch map: | | 6. Bore hole dia. <u>10</u> in. Completion date <u>5-19-76</u> Well depth <u>110</u> ft. | | |
|  | | <u>Well X</u> <u>no septic system as of date</u> <u>House</u> | | 7. <input checked="" type="checkbox"/> Cable tool <input type="checkbox"/> Rotary <input type="checkbox"/> Driven <input type="checkbox"/> Dug <input type="checkbox"/> Hollow rod <input type="checkbox"/> Jetted <input type="checkbox"/> Bored <input type="checkbox"/> Reverse rotary | | |
| 5. Type and color of material | | From | | To | | 8. Use: <input checked="" type="checkbox"/> Domestic <input type="checkbox"/> Public supply <input type="checkbox"/> Industry <input type="checkbox"/> Irrigation <input type="checkbox"/> Air conditioning <input type="checkbox"/> Stock <input type="checkbox"/> Lawn <input type="checkbox"/> Oil field water <input type="checkbox"/> Other |
| | | Red Clay | | 0 | | 9. Casing: Material <u>plastic</u> Height: Above or below Threaded <input type="checkbox"/> Welded <input type="checkbox"/> Surface <u>76</u> in. RMP <input checked="" type="checkbox"/> PVC <input type="checkbox"/> Weight <u>8</u> lbs./ft. Dia. <u>4</u> in. to <u>110</u> ft. depth Wall Thickness: inches or Dia. <u>4</u> in. to <u>110</u> ft. depth gage No. <u>175</u> |
| | | yellow lime | | 4 | | 10. Screen: Manufacturer's name <u>g & L</u> Type <u>RMP</u> Dia. <u>6 in</u> Slot/gauze <u>1/16</u> Length <u>20 ft</u> Set between <u>110</u> ft. and <u>110</u> ft. Gravel pack? <u>no</u> Size range of material |
| | | grey lime | | 9 | | 11. Static water level: <u>52</u> ft. below land surface Date <u>5-19-76</u> mo./day/yr. |
| | | Blue shale | | 39 | | 12. Pumping level below land surfaces: ft. after <u>1</u> hrs. pumping <u>20</u> g.p.m. ft. after <u>1</u> hrs. pumping <u>20</u> g.p.m. Estimated maximum yield <u>20</u> g.p.m. |
| | | grey lime | | 51 | | 13. Water sample submitted: <u>5-19-76</u> mo./day/yr. Yes <input checked="" type="checkbox"/> No <input type="checkbox"/> Date |
| | | water | | 102 | | 14. Well head completion: <input checked="" type="checkbox"/> Pitless adapter <u>14</u> inches above grade |
| | | grey lime | | 102 | | 15. Well grouted? <u>yes</u> With: <input checked="" type="checkbox"/> Neat cement <input type="checkbox"/> Bentonite <input type="checkbox"/> Concrete Depth: From <u>03</u> ft. to <u>14</u> ft. |
| | | | | | | 16. Nearest source of possible contamination: ft. Direction Type Well disinfected upon completion? <input checked="" type="checkbox"/> Yes <input type="checkbox"/> No |
| | | | | | | 17. Pump: Not installed Manufacturer's name <u>Howells</u> Model number <u>10EJ</u> HP <u>1/2</u> Volts <u>230</u> Length of drop pipe <u>100</u> ft. capacity <u>10</u> g.p.m. Type: <input checked="" type="checkbox"/> Submersible <input type="checkbox"/> Turbine <input type="checkbox"/> Jet <input type="checkbox"/> Reciprocating <input type="checkbox"/> Centrifugal <input type="checkbox"/> Other |
| 18. Elevation: | | 19. Remarks: | | 20. Water well contractor's certification: This well was drilled under my jurisdiction and this report is true to the best of my knowledge and belief. <u>Wike Well Drilling</u> 122 Business name License No. Address <u>Rt 3 Augusta Kans</u> Signed <u>Thurman Wike</u> Date <u>5-19-76</u> Authorized representative | | |

Forward the white, blue and pink copies to the Department of Health and Environment

Form WWC-5