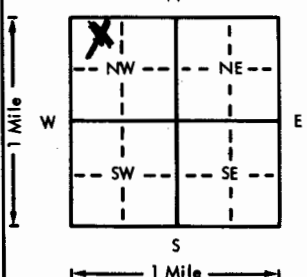
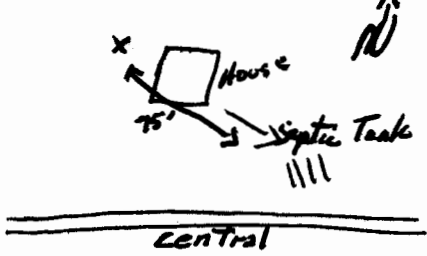


USE TYPEWRITER OR BALL
POINT PEN-PRESS FIRMLY,
PRINT CLEARLY.

WATER WELL RECORD
KSA 82a-1201-1215

Kansas Department of Health and
Environment-Division of Environment
(Water well Contractors)
Topeka, Kansas 66620

1. Location of well:		County Butler	Fraction NE 1/4 NW 1/4 NW 1/4	Section number 23	Township number T 27	Range number S R 3	(E)W
2. Distance and direction from nearest town or city: 3 E. on central ANDOVER		3. Owner of well: Pheland Baldwin					
Street address of well location if in city: lots 12, 3, 4, 5, 17, 18, 19, 20 CENTRAL PARK ADDITIONAL		R.R. or street: 2710 Merton					
4. Locate with "X" in section below:		Sketch map:				City, state, zip code: Wichita, KS	
						6. Bore hole dia. 10 in. Completion date 5/10/75 Well depth 45 ft.	
5. Type and color of material		From	To	7. <input checked="" type="checkbox"/> Cable tool <input type="checkbox"/> Rotary <input type="checkbox"/> Driven <input type="checkbox"/> D <input type="checkbox"/> Hollow rod <input type="checkbox"/> Jetted <input type="checkbox"/> Bored <input type="checkbox"/> Reverse rotary			
Top soil		0	6	8. Use: <input checked="" type="checkbox"/> Domestic <input type="checkbox"/> Public supply <input type="checkbox"/> Industry <input type="checkbox"/> Irrigation <input type="checkbox"/> Air conditioning <input type="checkbox"/> Stock <input type="checkbox"/> Lawn <input type="checkbox"/> Oil field water <input type="checkbox"/> Other			
Clay Brown		6	34	9. Casing: Material PVC Height 12 or below Threaded <input type="checkbox"/> Welded <input checked="" type="checkbox"/> Surface 12 in. RMP <input checked="" type="checkbox"/> PVC <input type="checkbox"/> Weight 120 lbs./ft. Dia. 6 in. to 25 ft. depth Wall Thickness: inches 0.125 Dia. 6 in. to 25 ft. depth Gage No. 0.125			
Shale gray		34	53	10. Screen: Manufacturer's name Southwestern Plastic Type RMP Dia. 6 Size/gauze 46 Length 20' Set between 75 ft. and 95 ft. ft. and 95 ft.			
shaley lime		53	70	11. Static water level: 32 ft. below land surface Date 5/10/75 mo./day/yr.			
Shale gray		70	92	12. Pumping level below land surfaces: ft. after 3 hrs. pumping 32 g.p.m. ft. after 3 hrs. pumping 32 g.p.m. Estimated maximum yield 32 g.p.m.			
lime gray		92	95	13. Water sample submitted: X Yes X No Date 5/10/75 mo./day/yr.			
				14. Well head completion: Pitless adapter X Inches above grade 15			
				15. Well grouted? URS With: X Neat cement <input type="checkbox"/> Bentonite <input type="checkbox"/> Concrete <input type="checkbox"/> Depth From 3 ft. to 15 ft.			
				16. Nearest source of possible contamination: ft. 15 Direction South E Type Septic Well disinfected upon completion? X Yes <input type="checkbox"/> No			
				17. Pump: X Not installed Manufacturer's name Reiserer Well Drilling Model number 100 HP 1/2 Volts 115 Length of drop pipe 15 ft. capacity 1/2 g.p.m. Type: <input type="checkbox"/> Submersible <input type="checkbox"/> Turbine <input type="checkbox"/> Jet <input type="checkbox"/> Reciprocating <input type="checkbox"/> Centrifugal <input type="checkbox"/> Other			
				(Use a second sheet if needed)			
18. Elevation:		19. Remarks:		20. Water well contractor's certification: This well was drilled under my jurisdiction and this report is true to the best of my knowledge and belief. Reiserer Well Drilling Business name Wichita, KS License No. 1/4 Address Wichita, KS Signed Reiserer Date 5/10/75 Authorized representative			

Forward the white, blue and pink copies to the Department of Health and Environment

Form WWC-5