


1 LOCATION OF WATER WELL:	Fraction	Section Number	Township Number	Range Number
County: Butler	NE 1/4 NW 1/4 SW 1/4	24	T 29 S	R 3 EW

Distance and direction from nearest town or city street address of well if located within city?

3 1/2 Mi. West of Augusta

2 WATER WELL OWNER:	Dale Brewster	Board of Agriculture, Division of Water Resources
RR#, St. Address, Box #	2638 S. Santa Fe	Application Number:
City, State, ZIP Code	Wichita, KS 67216	

3 LOCATE WELL'S LOCATION WITH AN "X" IN SECTION BOX:	4 DEPTH OF COMPLETED WELL. ft. ELEVATION:
--	---

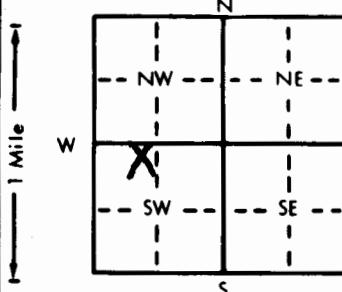

Depth(s) Groundwater Encountered 1. **85** ft. 2. **120** ft. 3. ft.

WELL'S STATIC WATER LEVEL **30** ft. below land surface measured on mo/day/yr **4/1/92**

Pump test data: Well water was ft. after hours pumping gpm

Est. Yield **15** gpm: Well water was ft. after hours pumping gpm

Bore Hole Diameter **10** in. to ft., and in. to ft.

WELL WATER TO BE USED AS: 5 Public water supply 8 Air conditioning 11 Injection well

Domestic 3 Feedlot 6 Oil field water supply 9 Dewatering 12 Other (Specify below)

2 Irrigation 4 Industrial 7 Lawn and garden only 10 Monitoring well

Was a chemical/bacteriological sample submitted to Department? Yes No If yes, mo/day/yr sample was submitted

Water Well Disinfected? Yes ✓ No

5 TYPE OF BLANK CASING USED:	5 Wrought iron	8 Concrete tile	CASING JOINTS: Glued Clamped
------------------------------	----------------	-----------------	--

1 Steel 3 RMP (SR) 6 Asbestos-Cement 9 Other (specify below) Welded

2 PVC 4 ABS 7 Fiberglass Threaded

Blank casing diameter **5** in. to ft., Dia in. to ft., Dia in. to ft.

Casing height above land surface **12** in., weight **160** lbs./ft. Wall thickness or gauge No.

TYPE OF SCREEN OR PERFORATION MATERIAL:

1 Steel 3 Stainless steel 5 Fiberglass 8 RMP (SR)

2 Brass 4 Galvanized steel 6 Concrete tile 9 ABS

PVC

10 Asbestos-cement

11 Other (specify)

12 None used (open hole)

SCREEN OR PERFORATION OPENINGS ARE:

1 Continuous slot **3 Mill slot** 5 Gauzed wrapped 8 Saw cut 11 None (open hole)

2 Louvered shutter 4 Key punched 6 Wire wrapped 9 Drilled holes

10 Other (specify)

SCREEN-PERFORATED INTERVALS: From ft. to ft., From ft. to ft.

From ft. to ft., From ft. to ft.

GRAVEL PACK INTERVALS: From ft. to ft., From ft. to ft.

From ft. to ft., From ft. to ft.

6 GROUT MATERIAL: 1 Neat cement 2 Cement grout 3 Bentonite 4 Other

Grout Intervals: From ft. to ft., From ft. to ft., From ft. to ft.

What is the nearest source of possible contamination:

1 Septic tank 4 Lateral lines 7 Pit privy 10 Livestock pens 14 Abandoned water well

2 Sewer lines 5 Cess pool **Sewage lagoon** 11 Fuel storage 15 Oil well/Gas well

3 Watertight sewer lines 6 Seepage pit 9 Feedyard 12 Fertilizer storage 16 Other (specify below)

13 Insecticide storage

How many feet? **50 +**

Direction from well? **down slope**

FROM TO LITHOLOGIC LOG FROM TO PLUGGING INTERVALS

0	7	dirt		
7	16	clay (green)		
16	72	yellow clay		
72	80	shale		
80	96	shaly lime		
96	104	red bed		
104	120	shaly lime		
120	140	lime		

7 CONTRACTOR'S OR LANDOWNER'S CERTIFICATION: This water well was (1) constructed, (2) reconstructed, or (3) plugged under my jurisdiction and was completed on (mo/day/year) **4/1/92** and this record is true to the best of my knowledge and belief. Kansas

Water Well Contractor's License No. **493** This Water Well Record was completed on (mo/day/yr)

under the business name of **Risser's Well Drilling** by (signature) **James Risser**