

WATER WELL RECORD Form WWC-5


Division of Water Resources App. No.

Well ID

Original Record Correction Change in Well

1 LOCATION OF WATER WELL: Use Fraction Section Number Township Number Range Number
County: Butler NE 1/4 SE 1/4 NW 1/4 29 T 27 S R 3 E W

2 WELL OWNER: Last Name: DJUMANIYAZOU First: Ikrom
Business:
Address: 653 S. Cherrywood Circle
City: Andover State: Kansas ZIP: 67002
Street or Rural Address where well is located (if unknown, distance and direction from nearest town or intersection):

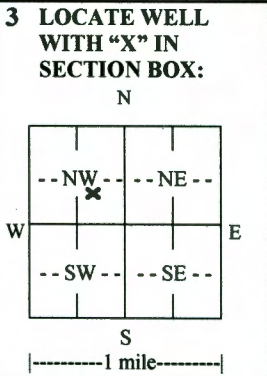

3 LOCATE WELL WITH 'X' IN SECTION BOX:
4 DEPTH OF COMPLETED WELL: 100 ft.
Depth(s) Groundwater Encountered: 1) 2) 3) 4) Dry Well
WELL'S STATIC WATER LEVEL: 35 ft.
below land surface, measured on (mo-day-yr) 07/16/21
above land surface, measured on (mo-day-yr)
Pump test data: Well water was after hours pumping gpm
Well water was after hours pumping gpm
Estimated Yield: gpm
Bore Hole Diameter: 12 in. to 100 ft. and in. to ft.

5 Latitude: 37.67589 (decimal degrees)
Longitude: -97.12803 (decimal degrees)
Horizontal Datum: WGS 84 NAD 83 NAD 27
Source for Latitude/Longitude:
GPS (unit make/model):
(WAAS enabled? Yes No)
Land Survey Topographic Map
Online Mapper:

6 Elevation: ft. Ground Level TOC
Source: Land Survey GPS Topographic Map
Other

7 WELL WATER TO BE USED AS:
1. Domestic: Household Lawn & Garden Livestock
2. Irrigation
3. Feedlot
4. Industrial
5. Public Water Supply: well ID
6. Dewatering: how many wells?
7. Aquifer Recharge: well ID
8. Monitoring: well ID
9. Environmental Remediation: well ID
Air Sparge Soil Vapor Extraction Recovery Injection
10. Oil Field Water Supply: lease
11. Test Hole: well ID Cased Uncased Geotechnical
12. Geothermal: how many bores?
a) Closed Loop Horizontal Vertical
b) Open Loop Surface Discharge Inj. of Water
13. Other (specify):

Was a chemical/bacteriological sample submitted to KDHE? Yes No
If yes, date sample was submitted:
Water well disinfected? Yes No

8 TYPE OF CASING USED: Steel PVC Other CASING JOINTS: Glued Clamped Welded Threaded
Casing diameter 5 in. to 100 ft. Diameter in. to ft. Diameter in. to ft.
Casing height above land surface 12 in. Weight 2.35 lbs./ft. Wall thickness or gauge No. SDR-26
TYPE OF SCREEN OR PERFORATION MATERIAL:
Steel Stainless Steel Fiberglass PVC Other (Specify)
Brass Galvanized Steel Concrete tile None used (open hole)
SCREEN OR PERFORATION OPENINGS ARE:
Continuous Slot Mill Slot Gauze Wrapped Torch Cut Drilled Holes Other (Specify)
Louvered Shutter Key Punched Wire Wrapped Saw Cut None (Open Hole)
SCREEN-PERFORATED INTERVALS: From 40 ft. to 100 ft. From ft. to ft. From ft. to ft.
GRAVEL PACK INTERVALS: From 24 ft. to 100 ft. From ft. to ft. From ft. to ft.

9 GROUT MATERIAL: Neat cement Cement grout Bentonite Other
Grout Intervals: From 4 ft. to 24 ft. From ft. to ft. From ft. to ft.
Nearest source of possible contamination:
Septic Tank Lateral Lines Pit Privy Livestock Pens Insecticide Storage
Sewer Lines Cess Pool Sewage Lagoon Fuel Storage Abandoned Water Well
Watertight Sewer Lines Seepage Pit Feedyard Fertilizer Storage Oil Well/Gas Well
Other (Specify)
Direction from well? South Distance from well? 23 ft. plus ft.

Table with 6 columns: 10 FROM, TO, LITHOLOGIC LOG, FROM, TO, LITHO. LOG (cont.) or PLUGGING INTERVALS. Rows show soil layers: topsoil (0-3), clay (3-12), brown shale (12-40), gray shale (40-95), limestone (95-100).

Notes:

11 CONTRACTOR'S OR LANDOWNER'S CERTIFICATION: This water well was constructed, reconstructed, or plugged under my jurisdiction and was completed on (mo-day-year) 07/16/2020 and this record is true to the best of my knowledge and belief.
Kansas Water Well Contractor's License No. 236 This Water Well Record was completed on (mo-day-year) 7/19/2021 under the business name of Harp Well and Pump Service Signature Todd S. Harp