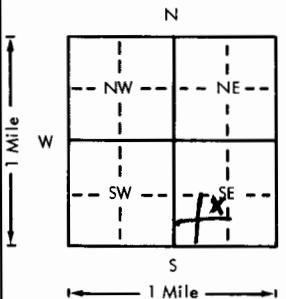
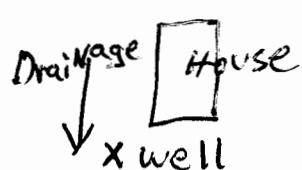


USE TYPEWRITER OR BALL
POINT PEN-PRESS FIRMLY,
PRINT CLEARLY.

WATER WELL RECORD
KSA 82a-1201-1215

Kansas Department of Health and
Environment-Division of Environment
(Water well Contractors)
Topeka, Kansas 66620

1. Location of well:	County <i>Butler</i>	Fraction <i>NE 1/4 SW 1/4 SE 1/4</i>	Section number <i>24</i>	Township number <i>T 27 S R 3 E 1/4</i>	Range number
2. Distance and direction from nearest town or city:	<i>3W 1/4 N of Augusta KS.</i>		3. Owner of well: R.R. or street: <i>Po box 41</i> City, state, zip code: <i>Andover KS 67002</i>		
4. Locate with "X" in section below:			Sketch map: 	6. Bore hole dia. <i>8.5</i> in. Completion date <i>4-4-79</i> Well depth <i>117</i> ft.	
5. Type and color of material	From	To	7. <input checked="" type="checkbox"/> Cable tool <input type="checkbox"/> Rotary <input type="checkbox"/> Driven <input type="checkbox"/> Dug <input type="checkbox"/> Hollow rod <input type="checkbox"/> Jetted <input type="checkbox"/> Bored <input type="checkbox"/> Reverse rotary		
<i>Top Soil</i>	<i>0</i>	<i>1</i>	8. Use: <input checked="" type="checkbox"/> Domestic <input type="checkbox"/> Public supply <input type="checkbox"/> Industry <input type="checkbox"/> Irrigation <input type="checkbox"/> Air conditioning <input type="checkbox"/> Stock <input type="checkbox"/> Lawn <input type="checkbox"/> Oil field water <input type="checkbox"/> Other		
<i>clay Redish brown</i>	<i>1</i>	<i>6</i>	9. Casing: Material <i>R/PS</i> Height: Above or below Threaded <input type="checkbox"/> Welded <i>glue</i> Surface <i>30</i> in. RMP <input checked="" type="checkbox"/> PVC <input type="checkbox"/> Weight <input type="checkbox"/> lbs./ft. Dia. <i>5</i> in. to <i>117</i> ft. depth Wall Thickness: inches or Dia. <input type="checkbox"/> in. to <input type="checkbox"/> ft. depth gage No. <i>200</i>		
<i>Limestone yellow</i>	<i>6</i>	<i>26</i>	10. Screen: Manufacturer's name <i>SUNFLOWER</i> <i>MFG</i> Type <i>RMP</i> Dia. <i>5</i> Slot/gauze <i>3/8</i> Length <i>10'</i> Set between <i>107</i> ft. and <i>117</i> ft. ft. and <i>117</i> ft. Gravel pack? <i>yes</i> Size range of material <i>18-34</i>		
<i>Limestone with clay yellow</i>	<i>26</i>	<i>38</i>	11. Static water level: <i>70</i> ft. below land surface Date <i>4-4-79</i> mo./day/yr.		
<i>Shale light green</i>	<i>38</i>	<i>46</i>	12. Pumping level below land surfaces: <i>NA</i> ft. after <input type="checkbox"/> hrs. pumping <input type="checkbox"/> g.p.m. ft. after <input type="checkbox"/> hrs. pumping <input type="checkbox"/> g.p.m. Estimated maximum yield <input type="checkbox"/> g.p.m.		
<i>Shale lavender</i>	<i>46</i>	<i>48</i>	13. Water sample submitted: <input type="checkbox"/> Yes <input checked="" type="checkbox"/> No Date <input type="checkbox"/>		
<i>Shale light gray</i>	<i>48</i>	<i>50</i>	14. Well head completion: <i>X</i> Pitless adapter <i>30</i> Inches above grade		
<i>Limestone yellow with clay</i>	<i>50</i>	<i>72</i>	15. Well grouted? <i>yes</i> With: <input type="checkbox"/> Neat cement <input type="checkbox"/> Bentonite <input checked="" type="checkbox"/> Concrete Depth: From <i>14</i> ft. to <i>4</i> ft.		
<i>Limestone yellow</i>	<i>72</i>	<i>95</i>	16. Nearest source of possible contamination: <i>NA</i> ft. <input type="checkbox"/> Direction <input type="checkbox"/> Type <input type="checkbox"/> Well disinfected upon completion? <i>X</i> Yes <input type="checkbox"/> No		
<i>Shale gray green</i>	<i>95</i>	<i>97</i>	17. Pump: <i>X</i> Not installed Manufacturer's name <input type="checkbox"/> Model number <input type="checkbox"/> HP <input type="checkbox"/> Volts <input type="checkbox"/> Length of drop pipe <input type="checkbox"/> ft. capacity <input type="checkbox"/> g.p.m. Type: <input type="checkbox"/> Submersible <input type="checkbox"/> Turbine <input type="checkbox"/> Jet <input type="checkbox"/> Reciprocating <input type="checkbox"/> Centrifugal <input type="checkbox"/> Other		
<i>Shale blue grey</i>	<i>97</i>	<i>101</i>			
<i>Shale Rusty Red</i>	<i>101</i>	<i>117</i>			
<i>(Water at 100)</i>					
(Use a second sheet if needed)					
18. Elevation:	19. Remarks:		<i>owner will install concrete slab</i>		
Topography:			20. Water well contractor's certification: This well was drilled under my jurisdiction and this report is true to the best of my knowledge and belief. <i>Bradley Water Well 5363</i> Business name <input type="checkbox"/> License No. <input type="checkbox"/> Address <i>1200 E 21st A Douglas KS</i> Signed <i>Richard Bradley</i> Date <i>4-4-79</i> Authorized representative <input type="checkbox"/>		