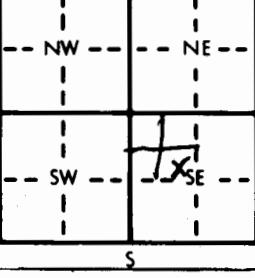
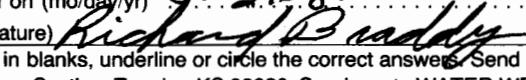


1 LOCATION OF WATER WELL:	Fraction County: Butler	Section Number SE 1/4 NW 1/4 SE 1/4	Township Number 24	Range Number T 27 S R 3 E	
Distance and direction from nearest town or city street address of well if located within city? 3 west 1/4 N of Augusta					
2 WATER WELL OWNER:	Bruce Davis				
RR#, St. Address, Box #:	R 3				
City, State, ZIP Code:	Augusta KS 67010				
3 LOCATE WELL'S LOCATION WITH AN "X" IN SECTION BOX:					
4 DEPTH OF COMPLETED WELL:	128 ft. ELEVATION: Slope				
Depth(s) Groundwater Encountered:	1. 89	ft. 2. 123	ft. 3. 5-21-82	ft.	
WELL'S STATIC WATER LEVEL:	95 ft. below land surface measured on mo/day/yr				
Pump test data: Well water was	ft. after	hours pumping	gpm		
Est. Yield	gpm:	Well water was	ft. after	hours pumping	gpm
Bore Hole Diameter	in. to	ft. and	in. to	ft.	
WELL WATER TO BE USED AS:	5 Public water supply	8 Air conditioning	11 Injection well		
① Domestic	3 Feedlot	6 Oil field water supply	9 Dewatering		
2 Irrigation	4 Industrial	7 Lawn and garden only	10 Observation well	12 Other (Specify below)	
Was a chemical/bacteriological sample submitted to Department? Yes.....No.....	If yes, mo/day/yr sample was submitted				
Water Well Disinfected? Yes <input checked="" type="checkbox"/> No <input type="checkbox"/>					
5 TYPE OF BLANK CASING USED:	5 Wrought iron	8 Concrete tile	CASING JOINTS: Glued <input checked="" type="checkbox"/> Clamped <input type="checkbox"/>		
1 Steel	3 RMP (SR)	6 Asbestos-Cement	9 Other (specify below)	Welded	
② PVC	4 ABS	7 Fiberglass		Threaded	
Blank casing diameter 5 in. to 128 ft. Dia.	in. to	ft. Dia	in. to	ft.	
Casing height above land surface 12 in., weight	lbs./ft.	Wall thickness or gauge No.			
TYPE OF SCREEN OR PERFORATION MATERIAL:	② PVC	10 Asbestos-cement			
1 Steel	3 Stainless steel	8 RMP (SR)	11 Other (specify)		
2 Brass	4 Galvanized steel	6 Concrete tile	9 ABS	12 None used (open hole)	
SCREEN OR PERFORATION OPENINGS ARE:	5 Fiberglass	5 Gauzed wrapped	② Saw cut	11 None (open hole)	
1 Continuous slot	3 Mill slot	6 Wire wrapped	9 Drilled holes		
2 Louvered shutter	4 Key punched	7 Torch cut	10 Other (specify)		
SCREEN-PERFORATED INTERVALS: From 128 ft. to 108 ft., From	ft. to	ft., From	ft. to	ft.	
From	ft. to	ft., From	ft. to	ft.	
GRAVEL PACK INTERVALS: From 128 ft. to 105 ft., From	ft. to	ft., From	ft. to	ft.	
From	ft. to	ft., From	ft. to	ft.	
6 GROUT MATERIAL:	1 Neat cement	② Cement grout	3 Bentonite	4 Other	
Grout Intervals: From 105 ft. to 85 ft., From	ft. to	ft. to	ft., From	ft. to	
What is the nearest source of possible contamination:	10 Livestock pens	14 Abandoned water well			
① Septic tank	4 Lateral lines	11 Fuel storage	15 Oil well/Gas well		
2 Sewer lines	5 Cess pool	12 Fertilizer storage	16 Other (specify below)		
3 Watertight sewer lines	6 Seepage pit	13 Insecticide storage			
Direction from well? NE	How many feet? 100				
FROM	TO	LITHOLOGIC LOG	FROM	TO	LITHOLOGIC LOG
0	6	Top Soil			
1	9	Limestone yellow			
9	63	Shale yellow gray			
63	74	Limestone yellow			
74	89	Shale yellow gray			
89	97	Shale gray			
97	123	Shale Rusty Red			
123	128	Shale gray			
7 CONTRACTOR'S OR LANDOWNER'S CERTIFICATION:	This water well was <input checked="" type="checkbox"/> constructed, (2) reconstructed, or (3) plugged under my jurisdiction and was completed on (mo/day/year) 5-21-82				and this record is true to the best of my knowledge and belief. Kansas
Water Well Contractor's License No. 363	This Water Well Record was completed on (mo/day/yr) 5-21-82				by (signature) 
INSTRUCTIONS: Use typewriter or ball point pen, PLEASE PRESS FIRMLY and PRINT clearly. Please fill in blanks, underline or circle the correct answers. Send top three copies to Kansas Department of Health and Environment, Division of Environment, Environmental Geology Section, Topeka, KS 66620. Send one to WATER WELL OWNER and retain one for your records.					