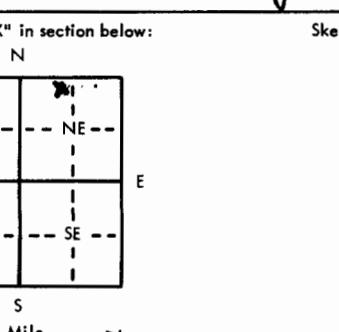


USE TYPEWRITER OR BALL
POINT PEN-PRESS FIRMLY,
PRINT CLEARLY.

WATER WELL RECORD
KSA 82a-1201-1215

Kansas Department of Health and
Environment-Division of Environment
(Water well Contractors)
Topeka, Kansas 66620

1. Location of well:	County Butler	Fraction NE 1/4 NW 1/4 NE 1/4	Section number 26	Township number T 27 S R 3	Range number 3
2. Distance and direction from nearest town or city:	4 1/4 West		3. Owner of well: a. g. Laham	B.W.	
Street address of well location if in city:	Augusta Kansas		R.R. or street: 204 Sunflower	City, state, zip code: Augusta Kansas	
4. Locate with "X" in section below:	Sketch map: 		6. Bore hole dia. 10 in. Completion date 6-22-1976 Well depth 80 ft.		
			7. <input checked="" type="checkbox"/> Cable tool <input type="checkbox"/> Rotary <input type="checkbox"/> Driven <input type="checkbox"/> Dug <input type="checkbox"/> Hollow rod <input checked="" type="checkbox"/> Jetted <input type="checkbox"/> Bored <input type="checkbox"/> Reverse rotary		
			8. Use: <input checked="" type="checkbox"/> Domestic <input type="checkbox"/> Public supply <input type="checkbox"/> Industry <input type="checkbox"/> Irrigation <input type="checkbox"/> Air conditioning <input type="checkbox"/> Stock <input type="checkbox"/> Lawn <input type="checkbox"/> Oil field water <input type="checkbox"/> Other		
			9. Casing: Material steel Height Above or below Threaded <input type="checkbox"/> Welded 10 Surface 15 in. RMP X PVC 10 Weight 10 lbs./ft. Dia. 6 in. to 80 ft. depth Wall Thickness: inches or Dia. 6 in. to 80 ft. depth Gage No. .175		
5. Type and color of material	From	To	10. Screen: Manufacturer's name gt Type RMP Dia. 6 Slat/gauze 10 Length 20 Set between 60 ft. and 80 ft. ft. and 80 ft. Gravel pack? no Size range of material.		
yellow Clay	0	13	11. Static water level: 41 ft. below land surface Date 6-22-1976		
grey lime	13	24	12. Pumping level below land surfaces: ft. after hrs. pumping g.p.m. ft. after hrs. pumping g.p.m. Estimated maximum yield 20 g.p.m.		
yellow lime	24	37	13. Water sample submitted: Yes <input checked="" type="checkbox"/> No <input type="checkbox"/> Date 6-22-1976		
Blue shale	37	49	14. Well head completion: Pitless adapter 15 Inches above grade		
grey lime	49	68	15. Well grouted? yes With: <input checked="" type="checkbox"/> Neat cement <input type="checkbox"/> Bentonite <input type="checkbox"/> Concrete Depth: From 3 ft. to 13 ft.		
water	68		16. Nearest source of possible contamination: ft. 125 Direction West Type Septic Well disinfected upon completion? <input checked="" type="checkbox"/> Yes <input type="checkbox"/> No		
grey lime	68	80	17. Pump: Manufacturer's name Monelar Not installed Model number 10EJ HP 1/2 Volts 230 Length of drop pipe 75 ft. capacity 10 g.p.m. Type: <input checked="" type="checkbox"/> Submersible <input type="checkbox"/> Turbine <input type="checkbox"/> Jet <input type="checkbox"/> Reciprocating <input type="checkbox"/> Centrifugal <input type="checkbox"/> Other		
(Use a second sheet if needed)			18. Elevation: Topography: <input type="checkbox"/> Hill <input type="checkbox"/> Slope <input checked="" type="checkbox"/> Upland <input type="checkbox"/> Valley		
19. Remarks:			20. Water well contractor's certification: This well was drilled under my jurisdiction and this report is true to the best of my knowledge and belief. Wike Well drilling 122 Business name R# 3 Box 128L License No. Address Augusta Signed Murray Wike Date 6-22-1976 Authorized representative Wike Date 6-22-1976		