

USE TYPEWRITER OR BALL
POINT PEN-PRESS FIRMLY,
PRINT CLEARLY.

WATER WELL RECORD
KSA 82a-1201-1215

T R EW sec 1/4 1/4 1/4 No.

Kansas State Dept. of Health
(Water Well Contractors)
Forbes-Bldg. 740
Topeka, Kansas 66620

NE NW SW


1 Location of well:	County	Township name	Fraction	Section number	Town number	Range number
	BUTLER	13 RUND		29	275	3E

Distance and direction from nearest town or city: LAKEVIEW
HICKETS ADDITION Vass of ANDERSON KS


Street address of well location if in city:

3 Owner of well: RANDY MAY
Address: WICHITA-KS 16108 Kere Lynn

Locate with "X" in section below:

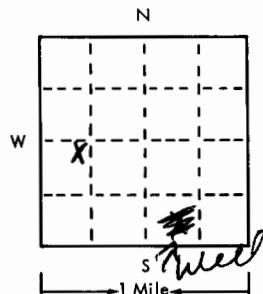

Sketch map:

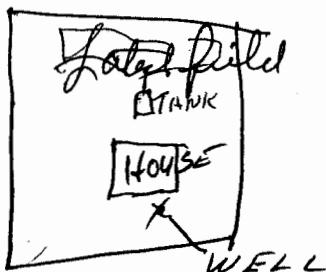

2	Type and color of material	From	To
	Reddish Brown Surface	0	4
	Yellow Clay	4	12
	Light Gray Clay	12	40
	Dark gray Clay	40	45
	Gray Water S. pale	45	47
	Dark Gray Clay	47	52

(use a second sheet if needed)

16 Remarks: elevation

Customer knew requirements of
4x4 slab.

Topography:

- Hill
- Slope
- Upland
- Valley

Randy May by Sub

Forward the white, blue and pink copies to the Kansas State Dept. of Health.

4 Well depth: 52 ft. Date of completion 5-15-75
Well diameter 8 in.

5 Cable tool Rotary Driven Dug
 Hollow rod Jetted Bored Reverse rotary

6 Use: Domestic Public supply Industry
 Irrigation Air conditioning Commercial
 Test well

7 Casing: Material PLASTIC Height: above/below
Threaded Welded Surface in.
Diam. Weight lbs./ft.
6 in. to 32 ft. depth Drive shoe? Yes No
in. to ft. depth

8 Screen:
Manufacturer SURFLOCER
Type 100 RMP Dia. 6 1/2
1/4" Screen gauze DRILLED Length 20 ft
Set between 32 ft. and 52 ft.
Fittings:
Gravel pack Yes No Size range of material 38

9 Static water level:
22 ft. below land surface Date 5-15-75

10 Pumping level below land surfaces:
ft. after hrs. pumping g.p.m.
ft. after hrs. pumping g.p.m.
Estimated maximum yield 25 g.p.m.

11 Water sample submitted:
 Yes No Date

12 Well head completion:
 Pitless adapter 15 inches above grade

13 Well grouted? Yes No
 Neat cement Bentonite
Depth: From 3 ft. to 15 ft.

14 Nearest source of possible contamination:
ft. 80 Direction NORTHE Type Septic
Well disinfected upon completion? Yes No

15 Pump:
Manufacturer's name
Model number HP Volts
Length of drop pipe ft. capacity g.m.p.
Type:
 Submersible Turbine
 Jet Reciprocating
 Centrifugal Other

17 Water well contractor's certification:
This well was drilled under my jurisdiction and this
report is true to the best of my knowledge and belief.
SIMMONS DRILLING 162
Business name 115 E CENTRAL ANDERSON
Address *Beulah* Date 5-17-75
Signed *Randy May* Authorized representative