

USE TYPEWRITER OR BALL
POINT PEN-PRESS FIRMLY,
PRINT CLEARLY.

WATER WELL RECORD
KSA 82a-1201-1215

11/12/75
T R EW sec 1/4 1/4 1/4 1/4 No.

Kansas State Dept. of Health
(Water Well Contractors)
Forbes-Bldg. 740
Topeka, Kansas 66620


NW SW SW NW

1 Location of well:	County	Township name	Fraction	Section number	Town number	Range number
	BUTLER	BRUNO	SW 1/4	29	275	3 EAST

Distance and direction from nearest town or city: 3 1/4 MI SO. HINSDALE
LAKEVIEW HEIGHTS ADDITION ON ROSEHILL RD
Street address of well location if in city: 1400 Rosehill Road (Crawellwell)

Locate with "X" in section below:

N

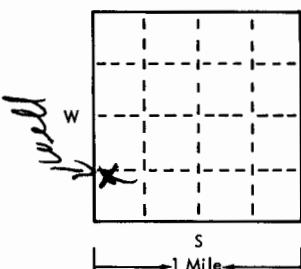

3 Owner of well: 2 T W N CONST CO

1440 COLLEEN TERRACE
WICHITA KS 67230

Address:

4 Well depth: 37 ft. Date of completion 1-18-75

Well diameter 8 in.

5 Cable tool Rotary Driven Dug
 Hollow rod Jetted Bored Reverse rotary

6 Use: Domestic Public supply Industry
 Irrigation Air conditioning Commercial
 Test well

7 Casing: Material ~~PLASTIC~~ Height: above below

Threaded ~~DRILLED~~ Surface 12 in.

Diam. 6 in. to 23 ft. depth Weight lbs./ft. 10
Drive shoe? Yes No
in. to ft. depth

8 Screen:
Manufacturer Simmons
Type 100 RMP Dia. 6"
~~100~~ drilled Length 14 ft
Set between 23 ft. and 37 ft.
Fittings:
Gravel pack Yes No Size range of material 36

9 Static water level: 15 ft. below land surface Date 1-18-75

10 Pumping level below land surfaces:
ft. after hrs. pumping g.p.m.
ft. after hrs. pumping g.p.m.
Estimated maximum yield 20 g.p.m.

11 Water sample submitted:
 Yes No Date

12 Well head completion: 12"
 Pitless adapter Inches above grade

13 Well grouted? Yes No
 Neat cement Bentonite
Depth: From 3 ft. to 15 ft.

14 Nearest source of possible contamination:
ft. 10 Direction NE Type Soil
Well disinfected upon completion? Yes No

15 Pump:
Manufacturer's name
Model number HP Volts
Length of drop pipe ft. capacity g.m.p.
Type:
 Submersible Turbine
 Jet Reciprocating
 Centrifugal Other

17 Water well contractor's certification:
This well was drilled under my jurisdiction and this
report is true to the best of my knowledge and belief.
Simmons DRILLING 162
Business name 115 E. CENTRAL HINSDALE License No.
Address Business Date 1-18-75
Signed Business Authorized representative

2	Type and color of material	From	To
	Brown Surface Silt	0	4
	Yellow Clay	4	20
	Limestone Rock	20	23
	Light Gray Water Shale	23	25
	Dark gray clay	25	31
	Gray Water Shale	31	34
	Gray clay	34	37

(use a second sheet if needed)

16 Remarks: elevation

Topography:

- Hill
- Slope
- Upland
- Valley

Customer Name & Requirements
8 510
Keith R. Zorn by DRB