USE TYPEWRITER OR BALL POINT PEN-PRESS FIRMLY, PRINT CLEARLY.

T R EW sec 1/4 1/4 1/4 No.

WATER WELL RECORD
KSA 82a-1201-1215

Kansas State Dept. Of Health
(Water Well Contractors)
Forbes-Bldg. 740
Topeka, Kansas 66620

1 Location of well:	County	Township name	Fraction	Section number	Town number	Range number
	BUTLER	BRUNO	NW¼/SW¼/SW¼	29	27S	3E

Distance and direction from nearest town or city: ¾ MI SOUTH ANDOVER ON ROSE HILL ROAD LAKEVIEW HEIGHTS ADD

Street address of well location if in city: 1400 Rose Hill Road

3 Owner of well: ZINN CONST CO

Address: 1440 COLLEN TERRACE WICHITA KS

Locate with "X" in section below:

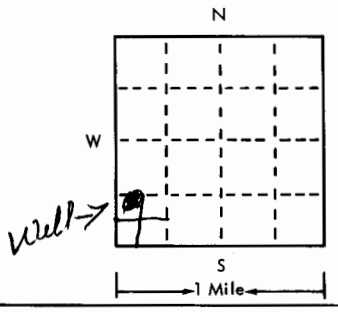

Sketch map:

4 Well depth: 49 ft. Date of completion 11-6-75
Well diameter 6 in.

5 [X] Cable tool [ ] Rotary [ ] Driven [ ] Dug
[ ] Hollow rod [ ] Jetted [ ] Bored [ ] Reverse rotary

6 Use: [X] Domestic [ ] Public supply [ ] Industry
[ ] Irrigation [ ] Air conditioning [ ] Commercial
[ ] Test well [ ] _____

7 Casing: Material RMP Height: (above)/below
Threaded [ ] Welded [ ] Surface 12 in.
Diam. 6 in. to 29 ft. depth Weight ____ lbs./ft.
____ in. to ____ ft. depth Drive shoe? [ ] Yes [X] No

2 Type and color of material	From	To
Brown Silt & Surface	0	4
Yellow Clay	4	20
Limestone Rock	20	23
Light Gray Water Shale	23	25
Dark Gray Clay	25	31
Gray Water Shales	31	34
Gray Clay	34	41
Limestone Rock	41	44
Dark Gray Water Shale	44	46
Dark Gray Clay	46	49
(use a second sheet if needed)		

8 Screen:
Manufacturer Sunflower Plastic
Type RMP Dia. ____
Slot/Gauze ¼" Drilled Length 20 ft
Set between 29 ft. and 49 ft.
Fittings:
Gravel pack [X] Yes [ ] No Size range of material 3/8 Pea Gravel

9 Static water level:
25 ft. below land surface Date 11-6-75

10 Pumping level below land surfaces:
____ ft. after ____ hrs. pumping ____ g.p.m.
____ ft. after ____ hrs. pumping ____ g.p.m.
Estimated maximum yield 20 g.p.m.

11 Water sample submitted:
[ ] Yes [X] No Date ____

12 Well head completion: Capped
[ ] Pitless adapter 12 inches above grade

13 Well grouted? [X] Yes [ ] No
[X] Neat cement [ ] Bentonite [ ] _____
Depth: From 3 ft. to 15 ft.

14 Nearest source of possible contamination:
ft. 90 Direction NORTH Type Septic
Well disinfected upon completion? [X] Yes [ ] No

15 Pump: [X] Not installed
Manufacturer's name ____
Model number ____ HP ____ Volts ____
Length of drop pipe ____ ft. capacity ____ g.m.p.
Type:
[ ] Submersible [ ] Turbine
[ ] Jet [ ] Reciprocating
[ ] Certrifugal [ ] Other

16 Remarks: elevation
Customer known requirements on 4' X 4' Concrete Slab

Topography:
[X] Hill
[ ] Slope
[ ] Upland
[ ] Valley

Keith R. Zinn

17 Water well contractor's certification:
This well was drilled under my jurisdiction and this report is true to the best of my knowledge and belief.
SIMMONS DRILLING 162
Business name License No.
Address 115 E. Central ANDOVER
Signed Ben Bruegge Date 11-15-75
Authorized representative

Forward the white, blue and pink copies to the Kansas State Dept. Of Health.

Form WWC-5

C ROAD

677-H