

1 LOCATION OF WATER WELL:	Fraction County: BUTLER	NW $\frac{1}{4}$ NW $\frac{1}{4}$ NE $\frac{1}{4}$	Section Number 29	Township Number T 27 S	Range Number R 3 E E/W
---------------------------	----------------------------	--	----------------------	---------------------------	---------------------------


Distance and direction from nearest town or city street address of well if located within city?

$\frac{1}{4}$ No. of Augusta Airport on the East side of Road Augusta, Ks.

2 WATER WELL OWNER: Dennis Legge

RR#, St. Address, Box # : 217 West 3rd. Apartment 6A Board of Agriculture, Division of Water Resources
City, State, ZIP Code : Andover, Kansas 67002 Application Number:

3 LOCATE WELL'S LOCATION WITH AN "X" IN SECTION BOX:

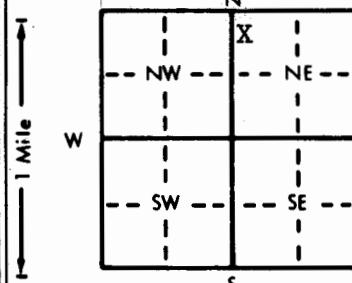

4 DEPTH OF COMPLETED WELL.....140..... ft. ELEVATION:

Depth(s) Groundwater Encountered 1.....80..... ft. 2..... ft. 3..... ft.

WELL'S STATIC WATER LEVEL80..... ft. below land surface measured on mo/day/yr .. 12-2-83

Pump test data: Well water was ft. after hours pumping gpm

Est. Yield gpm: Well water was ft. after hours pumping gpm

Bore Hole Diameter.....11.....in. to ft., and in. to ft.

WELL WATER TO BE USED AS: 5 Public water supply 8 Air conditioning 11 Injection well

1 Domestic 3 Feedlot 6 Oil field water supply 9 Dewatering 12 Other (Specify below)

2 Irrigation 4 Industrial 7 Lawn and garden only 10 Observation well

Was a chemical/bacteriological sample submitted to Department? Yes.....No..... If yes, mo/day/yr sample was submitted

Water Well Disinfected? Yes No

5 TYPE OF BLANK CASING USED:

1 Steel	3 RMP (SR)	5 Wrought iron	8 Concrete tile	CASING JOINTS: Glued <input checked="" type="checkbox"/> Clamped
2 PVC	4 ABS	6 Asbestos-Cement	9 Other (specify below)	Welded
		7 Fiberglass	c-M styrene SDR-26	Threaded

Blank casing diameter5.....in. to80..... ft., Diain. to ft., Diain. to ft.

Casing height above land surface12.....in., weight1.59..... lbs./ft. Wall thickness or gauge No.203.....

TYPE OF SCREEN OR PERFORATION MATERIAL:

1 Steel	3 Stainless steel	5 Fiberglass	8 RMP (SR)	10 Asbestos-cement
2 Brass	4 Galvanized steel	6 Concrete tile	9 ABS	11 Other (specify)

SCREEN OR PERFORATION OPENINGS ARE:

1 Continuous slot	3 Mill slot	5 Gauzed wrapped	8 Saw cut	11 None (open hole)
2 Louvered shutter	4 Key punched	6 Wire wrapped	9 Drilled holes	12 None used (open hole)
		7 Torch cut	10 Other (specify)	

SCREEN-PERFORATED INTERVALS: From.....80..... ft. to140..... ft., From ft. to ft.

From ft. to ft., From ft. to ft.

GRAVEL PACK INTERVALS: From.....14..... ft. to140..... ft., From ft. to ft.

From ft. to ft., From ft. to ft.

6 GROUT MATERIAL: 1 Neat cement 2 Cement grout 3 Bentonite 4 Other

Grout Intervals: From.....4..... ft. to14..... ft., From ft. to ft., From ft. to ft.

What is the nearest source of possible contamination:

1 Septic tank	4 Lateral lines	7 Pit privy	10 Livestock pens	14 Abandoned water well
2 Sewer lines	5 Cess pool	8 Sewage lagoon	11 Fuel storage	15 Oil well/Gas well
3 Watertight sewer lines	6 Seepage pit	9 Feedyard	12 Fertilizer storage	16 Other (specify below)

.....None Apparent.....

Direction from well?

FROM	TO	LITHOLOGIC LOG	FROM	TO	LITHOLOGIC LOG
------	----	----------------	------	----	----------------

0	3	Topsoil			
---	---	---------	--	--	--

3	7	Clay			
---	---	------	--	--	--

7	56	Brown Shale			
---	----	-------------	--	--	--

56	115	Gray Shale			
----	-----	------------	--	--	--

115	140	Limestone			
-----	-----	-----------	--	--	--

--	--	--	--	--	--

--	--	--	--	--	--

