


1 LOCATION OF WATER WELL:	Fraction County: <i>Batler</i>	SW $\frac{1}{4}$ NW $\frac{1}{4}$ NE $\frac{1}{4}$	Section Number 29	Township Number T 27 S	Range Number R 3 E/W
---------------------------	-----------------------------------	--	----------------------	---------------------------	-------------------------

Distance and direction from nearest town or city street address of well if located within city?

*9 West of Augusta*

2 WATER WELL OWNER:	Jim Hyring	Wichita Kan	Board of Agriculture, Division of Water Resources
RR#, St. Address, Box #:	162 90 Tower	67230	Application Number:

3 LOCATE WELL'S LOCATION WITH AN "X" IN SECTION BOX:	4 DEPTH OF COMPLETED WELL: 65 ft. ELEVATION: 65
--	---

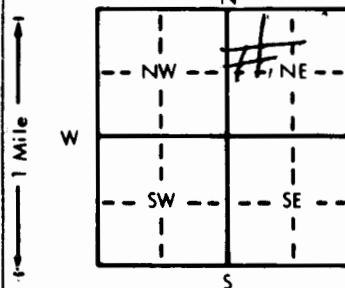

Depth(s) Groundwater Encountered 1. 40 ft. 2. ft. 3. ft.

WELL'S STATIC WATER LEVEL 20 ft. below land surface measured on mo/day/yr

Pump test data: Well water was ft. after hours pumping gpm

Est. Yield 30 gpm: Well water was ft. after hours pumping gpm

Bore Hole Diameter 85 in. to ft., and in. to ft.

WELL WATER TO BE USED AS: 5 Public water supply 8 Air conditioning 11 Injection well

1 Domestic 3 Feedlot 6 Oil field water supply 9 Dewatering 12 Other (Specify below)

2 Irrigation 4 Industrial 7 Lawn and garden only 10 Monitoring well

Was a chemical/bacteriological sample submitted to Department? Yes No; If yes, mo/day/yr sample was submitted

Water Well Disinfected? Yes X No

5 TYPE OF BLANK CASING USED:	5 Wrought iron	8 Concrete tile	CASING JOINTS: Glued X Clamped
------------------------------	----------------	-----------------	--------------------------------

1 Steel 3 RMP (SR)  
2 PVC 4 ABS

Blank casing diameter 15 in. to 30 ft., Dia. in. to ft., Dia. in. to ft.

Casing height above land surface 18 in., weight 160 lbs./ft. Wall thickness or gauge No. 214

6 TYPE OF SCREEN OR PERFORATION MATERIAL:	7 PVC	10 Asbestos-cement
---	-------	--------------------

1 Steel 3 Stainless steel  
2 Brass 4 Galvanized steel5 Fiberglass 8 RMP (SR)  
6 Concrete tile 9 ABS

5 Gauzed wrapped 11 Other (specify)

6 Wire wrapped 12 None used (open hole)

7 Torch cut 13 Insecticide storage

8 Saw cut 14 Abandoned water well

9 Drilled holes 15 Oil well/Gas well

10 Other (specify) 16 Other (specify below)

SCREEN-PERFORATED INTERVALS:	From 30 ft. to 65 ft.	From ft. to ft.	From ft. to ft.
------------------------------	-----------------------	-----------------	-----------------

From ft. to ft. From ft. to ft. From ft. to ft.

GRAVEL PACK INTERVALS:	From ft. to ft.	From ft. to ft.	From ft. to ft.
------------------------	-----------------	-----------------	-----------------

From ft. to ft. From ft. to ft. From ft. to ft.

6 GROUT MATERIAL:	1 Neat cement	2 Cement grout	3 Bentonite	4 Other
-------------------	---------------	----------------	-------------	---------

Grout Intervals: From 0 ft. to 20 ft., From ft. to ft., From ft. to ft., From ft. to ft.

What is the nearest source of possible contamination:

1 Septic tank 4 Lateral lines  
2 Sewer lines 5 Cess pool  
3 Watertight sewer lines 6 Seepage pit7 Pit privy  
8 Sewage lagoon  
9 Feedyard

10 Livestock pens

11 Fuel storage

12 Fertilizer storage

13 Insecticide storage

14 Abandoned water well

15 Oil well/Gas well

16 Other (specify below)

Direction from well? E

How many feet? 200

FROM	TO	LITHOLOGIC LOG	FROM	TO	PLUGGING INTERVALS
------	----	----------------	------	----	--------------------

0	3	Soil			
---	---	------	--	--	--

3	7	Clay			
---	---	------	--	--	--

7	65	Shale & Lime			
---	----	--------------	--	--	--

7 CONTRACTOR'S OR LANDOWNER'S CERTIFICATION: This water well was (1) constructed, (2) reconstructed, or (3) plugged under my jurisdiction and was completed on (mo/day/year) 3/1/90 and this record is true to the best of my knowledge and belief. Kansas
--

Water Well Contractor's License No. 26 This Water Well Record was completed on (mo/day/yr) 3/1/90 under the business name of Winter Well Drill by (signature) Charles Winter