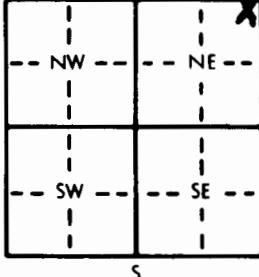
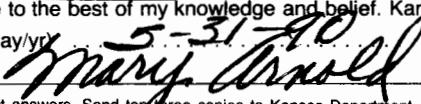


WATER WELL RECORD

Form WWC-5

KSA 82a-1212

1 LOCATION OF WATER WELL:		Fraction County: Butler Distance and direction from nearest town or city street address of well if located within city?	Section Number NE $\frac{1}{4}$ NE $\frac{1}{4}$ NE $\frac{1}{4}$ 29	Township Number T 27 S	Range Number R 3E E/W		
2 WATER WELL OWNER:		Melvin J. Marshall					
RR#, St. Address, Box #:		627 Doolittle					
City, State, ZIP Code:		Wichita, Ks. 67230					
3 LOCATE WELL'S LOCATION WITH AN "X" IN SECTION BOX:							
4 DEPTH OF COMPLETED WELL:		40 ft. ELEVATION: ft. PTT FLOOR					
Depth(s) Groundwater Encountered:		ft. 2. ft. 3. ft.					
WELL'S STATIC WATER LEVEL:		5 ft. below land surface measured on mo/day/yr 3-15-90					
Pump test data: Well water was		ft. after hours pumping gpm					
Est. Yield gpm: Well water was		ft. after hours pumping gpm					
Bore Hole Diameter unknown in. to		ft. and in. to ft.					
WELL WATER TO BE USED AS:		5 Public water supply 8 Air conditioning 11 Injection well 1 Domestic 3 Feedlot 6 Oil field water supply 9 Dewatering 12 Other (Specify below) 2 Irrigation 4 Industrial 7 Lawn and garden only 10 Monitoring well					
Was a chemical/bacteriological sample submitted to Department? Yes..... No.....		If yes, mo/day/yr sample was submitted					
Water Well Disinfected? Yes		No					
5 TYPE OF BLANK CASING USED:		5 Wrought iron	8 Concrete tile	CASING JOINTS: Glued Clamped			
1 Steel galv 3 RMP (SR)		6 Asbestos-Cement	9 Other (specify below)	Welded			
2 PVC 4 ABS		7 Fiberglass	Threaded			
Blank casing diameter 6 in. to ft., Dia.	 in. to ft., Dia. in. to ft. in. to ft.			
Casing height DEWELL & PTT FLOOR 36 in., weight	 lbs./ft.	Wall thickness or gauge No.				
TYPE OF SCREEN OR PERFORATION MATERIAL:		7 PVC	10 Asbestos-cement			
1 Steel 3 Stainless steel		5 Fiberglass	8 RMP (SR)	11 Other (specify)			
2 Brass 4 Galvanized steel		6 Concrete tile	9 ABS	12 None used (open hole)			
SCREEN OR PERFORATION OPENINGS ARE:		5 Gauzed wrapped	8 Saw cut	11 None (open hole)			
1 Continuous slot 3 Mill slot		6 Wire wrapped	9 Drilled holes			
2 Louvered shutter 4 Key punched		7 Torch cut	10 Other (specify)			
SCREEN-PERFORATED INTERVALS: From..... ft. to..... ft., From..... ft. to..... ft., From..... ft. to..... ft.	 ft. to..... ft.			
GRAVEL PACK INTERVALS: From..... ft. to..... ft., From..... ft. to..... ft., From..... ft. to..... ft.	 ft. to..... ft.			
6 GROUT MATERIAL: 1 Neat cement 2 Cement grout 3 Bentonite 4 Other				
Grout Intervals: From..... ft. to..... ft., From..... ft. to..... ft., From..... ft. to..... ft., From..... ft. to..... ft.				
What is the nearest source of possible contamination:		10 Livestock pens	14 Abandoned water well			
1 Septic tank 4 Lateral lines		11 Fuel storage	15 Oil well/Gas well			
2 Sewer lines 5 Cess pool		12 Fertilizer storage	16 Other (specify below)			
3 Watertight sewer lines 6 Seepage pit		13 Insecticide storage			
Direction from well? SouthWest		How many feet? 55			
FROM	TO	LITHOLOGIC LOG		FROM	TO	PLUGGING INTERVALS	
				0	7	concrete	
				7	20	bentonite hole plug & sand	
				20	24	hole plug	
				24	40	chlorinated gravel	
7 CONTRACTOR'S OR LANDOWNER'S CERTIFICATION: This water well was (1) constructed, (2) reconstructed, or (3) plugged under my jurisdiction and was completed on (mo/day/year) 3-15-90		and this record is true to the best of my knowledge and belief. Kansas					
Water Well Contractor's License No. 236		This Water Well Record was completed on (mo/day/yr) 5-31-90					
under the business name of Harp Well and Pump Service, Inc.		by (signature) 					

INSTRUCTIONS: Use typewriter or ball point pen. PLEASE PRESS FIRMLY and PRINT clearly. Please fill in blanks, underline or circle the correct answers. Send top three copies to Kansas Department of Health and Environment, Bureau of Water, Topeka, Kansas 66620-7320. Telephone: 913-296-5545. Send one to WATER WELL OWNER and retain one for your records.