

## WATER WELL RECORD

Form WWC-5

KSA 82a-1212

1 LOCATION OF WATER WELL:	Fraction	Section Number	Township Number	Range Number
County: BUTLER	SW 1/4	SW 1/4	SW 1/4	30 T 27 S R 3 E E/W

Distance and direction from nearest town or city street address of well if located within city?

16046 E. Harry

Wichita, Ks.

1/4 West of Andover Rd., on Harry

2 WATER WELL OWNER: Ray Baker


RR#, St. Address, Box #: 16046 E. Harry

Board of Agriculture, Division of Water Resources

City, State, ZIP Code: Wichita, Kansas 67230

Application Number:

3 LOCATE WELL'S LOCATION WITH AN "X" IN SECTION BOX:

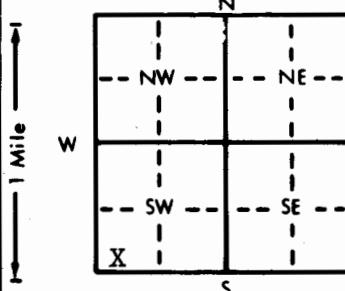

4 DEPTH OF COMPLETED WELL... 45 ft. ELEVATION: .....

Depth(s) Groundwater Encountered 1. 15 ft. 2. ft. 3. ft.

WELL'S STATIC WATER LEVEL .15 ft. below land surface measured on mo/day/yr .5-29-84

Pump test data: Well water was ft. after hours pumping gpm

Est. Yield gpm: Well water was ft. after hours pumping gpm

Bore Hole Diameter .11 in. to ft., and .in. to ft.

WELL WATER TO BE USED AS: 5 Public water supply 8 Air conditioning 11 Injection well

1 Domestic 3 Feedlot 6 Oil field water supply 9 Dewatering 12 Other (Specify below)

2 Irrigation 4 Industrial 7 Lawn and garden only 10 Observation well

Was a chemical/bacteriological sample submitted to Department? Yes.....No.  If yes, mo/day/yr sample was submittedWater Well Disinfected? Yes  No

5 TYPE OF BLANK CASING USED:

1 Steel 3 RMP (SR)

2 PVC 4 ABS

5 Wrought iron

6 Asbestos-Cement

7 Fiberglass

8 Concrete tile

9 Other (specify below)

Cer-Mac styrene SDR-26

CASING JOINTS: Glued  Clamped

Welded

Threaded

Blank casing diameter .5 in. to .25 ft., Dia . in. to . ft., Dia . in. to . ft.

Casing height above land surface .12 in., weight .1.59 lbs./ft. Wall thickness or gauge No. .203

TYPE OF SCREEN OR PERFORATION MATERIAL:

1 Steel 3 Stainless steel

2 Brass 4 Galvanized steel

5 Fiberglass

6 Concrete tile

7 PVC

8 RMP (SR)

9 ABS

10 Asbestos-cement

11 Other (specify)

12 None used (open hole)

SCREEN OR PERFORATION OPENINGS ARE:

1 Continuous slot 3 Mill slot

2 Louvered shutter 4 Key punched

5 Gauzed wrapped

6 Wire wrapped

7 Torch cut

8 Saw cut

9 Drilled holes

10 Other (specify)

11 None (open hole)

SCREEN-PERFORATED INTERVALS: From .25 ft. to .45 ft., From . ft. to . ft.

From . ft. to . ft., From . ft. to . ft.

GRAVEL PACK INTERVALS: From .14 ft. to .45 ft., From . ft. to . ft.

From . ft. to . ft., From . ft. to . ft.

6 GROUT MATERIAL: 1 Neat cement 2 Cement grout 3 Bentonite 4 Other

Grout Intervals: From .4 ft. to .14 ft., From . ft. to . ft., From . ft. to . ft.

What is the nearest source of possible contamination:

1 Septic tank 4 Lateral lines

2 Sewer lines 5 Cess pool

3 Watertight sewer lines 6 Seepage pit

7 Pit privy

8 Sewage lagoon

9 Feedyard

10 Livestock pens

11 Fuel storage

12 Fertilizer storage

13 Insecticide storage

14 Abandoned water well

15 Oil well/Gas well

16 Other (specify below)

Direction from well? West How many feet? 55

FROM TO LITHOLOGIC LOG FROM TO LITHOLOGIC LOG

0 3 Topsoil

3 11 Clay

11 45 Grey Shale

7 CONTRACTOR'S OR LANDOWNER'S CERTIFICATION: This water well was (1) constructed, (2) reconstructed, or (3) plugged under my jurisdiction and was completed on (mo/day/year) .5-29-84 and this record is true to the best of my knowledge and belief. Kansas

Water Well Contractor's License No. .236 This Water Well Record was completed on (mo/day/yr) .5-31-84

under the business name of Harp Well & Pump Service, Inc. by (signature) *Mary Arnold*

INSTRUCTIONS: Use typewriter or ball point pen, PLEASE PRESS FIRMLY and PRINT clearly. Please fill in blanks, underline or circle the correct answers. Send top three copies to Kansas Department of Health and Environment, Division of Environment, Environmental Geology Section, Topeka, KS 66620. Send one to WATER WELL OWNER and retain one for your records.