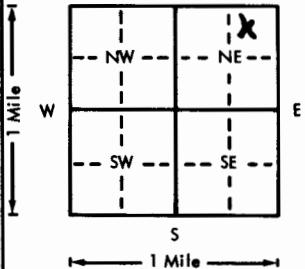


USE TYPEWRITER OR BALL
POINT PEN-PRESS FIRMLY,
PRINT CLEARLY.

WATER WELL RECORD
KSA 82a-1201-1215

Kansas Department of Health and
Environment-Division of Environment
(Water well Contractors)
Topeka, Kansas 66620

1. Location of well:	County <i>Butler</i>	Fraction <i>NW 1/4 NE 1/4, NE 1/4</i>	Section number <i>30</i>	Township number <i>T 27 S</i>	Range number <i>R 3 E</i>
2. Distance and direction from nearest town or city:	<i>814 Allen</i>				
Street address of well location if in city:	<i>Wichita, Kans.</i>				
4. Locate with "X" in section below:	Sketch map: 				
5. Type and color of material	From	To			
<i>Dirt</i>	<i>0 3</i>				
<i>Clay</i>	<i>3 5</i>				
<i>Limestone</i>	<i>5 15</i>				
<i>Shale</i>	<i>45 81</i>				
(Use a second sheet if needed)					
18. Elevation:	19. Remarks:				
Topography: <input checked="" type="checkbox"/> Hill <input checked="" type="checkbox"/> Slope <input type="checkbox"/> Upland <input type="checkbox"/> Valley					
3. Owner of well: <i>R.O. Arnold, Sen Concrete</i> R.R. or street: <i>14405 Willowbend Circle</i> City, state, zip code: <i>Wichita, Kansas</i>					
6. Bore hole dia. <u>11</u> in. Completion date <u>1-15-76</u> Well depth <u>81</u> ft.					
7. <input type="checkbox"/> Cable tool <input checked="" type="checkbox"/> Rotary <input type="checkbox"/> Driven <input type="checkbox"/> Dug <input type="checkbox"/> Hollow rod <input type="checkbox"/> Jetted <input type="checkbox"/> Bored <input type="checkbox"/> Reverse rotary					
8. Use: <input checked="" type="checkbox"/> Domestic <input type="checkbox"/> Public supply <input type="checkbox"/> Industry <input type="checkbox"/> Irrigation <input type="checkbox"/> Air conditioning <input type="checkbox"/> Stock <input type="checkbox"/> Lawn <input type="checkbox"/> Oil field water <input type="checkbox"/> Other					
9. Casing: Material <u>Steel</u> Length <u>12</u> in. Threaded <input type="checkbox"/> Welded <input type="checkbox"/> Surface <u>12</u> in. RMP <input checked="" type="checkbox"/> PVC <input type="checkbox"/> Weight <input type="checkbox"/> lbs./ft. Dia. <u>5</u> in. to <u>81</u> ft. depth Wall Thickness: inches or Dia. <input type="checkbox"/> in. to <input type="checkbox"/> ft. depth gage No. <u>-200</u>					
10. Screen: Manufacturer's name <u>Swallow Plastic</u> Type <u>Styrene</u> Dia. <u>5"</u> Slot/gauze <u>.06</u> Length <u>40'</u> Set between <u>41</u> ft. and <u>81</u> ft. ft. and <u>81</u> ft. Gravel pack? <u>yes</u> Size range of material <u>1/4-1/8"</u>					
11. Static water level: <u>36</u> ft. below land surface Date <u>1-15-76</u> mo./day/yr.					
12. Pumping level below land surfaces: <u>36</u> ft. after <u>0</u> hrs. pumping g.p.m. <u>36</u> ft. after <u>0</u> hrs. pumping g.p.m. Estimated maximum yield g.p.m.					
13. Water sample submitted: mo./day/yr. Yes <input type="checkbox"/> No <input type="checkbox"/> Date					
14. Well head completion: <input checked="" type="checkbox"/> Pitless adapter <u>12</u> inches above grade					
15. Well grouted <u>yes</u> With: <input type="checkbox"/> Neat cement <input type="checkbox"/> Bentonite <input checked="" type="checkbox"/> Concrete Depth: From <u>40</u> ft. to <u>14</u> ft.					
16. Nearest source of possible contamination: <u>80</u> ft. Direction <u>SW</u> Type <u>Septic tank</u> Well disinfected upon completion? <input checked="" type="checkbox"/> Yes <input type="checkbox"/> No					
17. Pump: Not installed Manufacturer's name <u>Ultra-Rite</u> Model number <u>LP6002</u> HP <u>3/4</u> Volts <u>230</u> Length of drop pipe <u>60</u> ft. capacity <u>30</u> g.p.m. Type: <input checked="" type="checkbox"/> Submersible <input type="checkbox"/> Turbine <input type="checkbox"/> Jet <input type="checkbox"/> Reciprocating <input type="checkbox"/> Centrifugal <input type="checkbox"/> Other					
20. Water well contractor's certification: This well was drilled under my jurisdiction and this report is true to the best of my knowledge and belief. <i>Warp Well Pump 236</i> Business name <u>Warp Well Pump 236</u> License No. <u>1000</u> Address <u>Wichita, Kansas</u> Signed <u>R.O. Arnold</u> Date <u>1-17-76</u> Authorized representative					