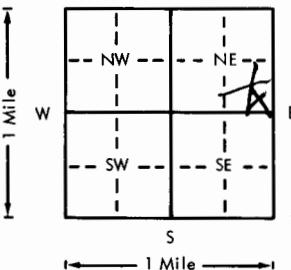
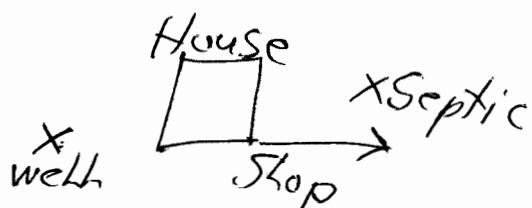


USE TYPEWRITER OR BALL
POINT PEN-PRESS FIRMLY,
PRINT CLEARLY.

WATER WELL RECORD
KSA 82a-1201-1215

Kansas Department of Health and
Environment-Division of Environment
(Water well Contractors)
Topeka, Kansas 66620

1. Location of well:	County Batler	Fraction SE 1/4 SE 1/4 NE 1/4	Section number 30	Township number 27	Range number 3
2. Distance and direction from nearest town or city:	3 S of Andover		3. Owner of well: Frederick PLAMMER		
Street address of well location if in city:			R.R. or street: 1721 Jerry	City, state, zip code: Andover, Kan 67002	
4. Locate with "X" in section below:	Sketch map:		6. Bore hole dia. 8 in. Completion date 7/8/79 Well depth 65 ft.		
				7. <input checked="" type="checkbox"/> Cable tool <input type="checkbox"/> Rotary <input type="checkbox"/> Driven <input type="checkbox"/> Dug <input type="checkbox"/> Hollow rod <input type="checkbox"/> Jetted <input type="checkbox"/> Bored <input type="checkbox"/> Reverse rotary	
5. Type and color of material	From	To	8. Use: <input checked="" type="checkbox"/> Domestic <input type="checkbox"/> Public supply <input type="checkbox"/> Industry <input type="checkbox"/> Irrigation <input type="checkbox"/> Air conditioning <input type="checkbox"/> Stock <input type="checkbox"/> Lawn <input type="checkbox"/> Oil field water <input type="checkbox"/> Other		
Soil	0	5	9. Casing: Material PVC Height: Above or below Threaded <input type="checkbox"/> Welded Surface 18 in. RMP 100 lbs./ft. Weight 100 lbs./ft. Dia. 5 in. to 65 ft. depth Wall Thickness: inches or Dia. 5 in. to 65 ft. depth Gage No. 115		
Clay	5	15	10. Screen: Manufacturer's name ScenFlower Type 100 Dia. 5 Slot/gauze 1/16 Length 20 Set between 18 ft. and 65 ft. Gravel pack? None Size range of material _____		
Rock	15	25	11. Static water level: 35 ft. below land surface Date 7/8/79		
Shale	25	35	12. Pumping level below land surfaces: Balancing 40 ft. after hrs. pumping g.p.m. 40 ft. after hrs. pumping g.p.m. Estimated maximum yield 20 g.p.m.		
Water	35	60	13. Water sample submitted: mo./day/yr. Yes <input checked="" type="checkbox"/> No _____ Date _____		
			14. Well head completion: Pitless adapter _____ Inches above grade		
			15. Well grouted? Yes With: <input type="checkbox"/> Neat cement <input checked="" type="checkbox"/> Bentonite <input checked="" type="checkbox"/> Concrete Depth: From 0 ft. to 70 ft.		
			16. Nearest source of possible contamination: ft. 100 Direction E Type Septic Well disinfected upon completion? <input checked="" type="checkbox"/> Yes <input type="checkbox"/> No		
			17. Pump: Manufacturer's name _____ <input checked="" type="checkbox"/> Not installed Model number _____ HP _____ Volts _____ Length of drop pipe _____ ft. capacity _____ g.p.m. Type: <input type="checkbox"/> Submersible <input type="checkbox"/> Turbine <input type="checkbox"/> Jet <input type="checkbox"/> Reciprocating <input type="checkbox"/> Centrifugal <input type="checkbox"/> Other		
(Use a second sheet if needed)			20. Water well contractor's certification: This well was drilled under my jurisdiction and this report is true to the best of my knowledge and belief. Winter Well Drilling Business name P2 Box 30 Augusta License No. 2575 Address Kansas Date 3/10/80 Signed Mark Winter Authorized representative Mark Winter		
18. Elevation:	19. Remarks:				
Topography:					
<input type="checkbox"/> Hill <input type="checkbox"/> Slope <input checked="" type="checkbox"/> Upland <input type="checkbox"/> Valley					