


1 LOCATION OF WATER WELL: Fraction SW 1/4 NE 1/4 NE 1/4 Section Number 30 Township Number T 27 S Range Number R 3 E  
 County: BUTLER

Distance and direction from nearest town or city street address of well if located within city?  
640 Daisy Andover Ks.

2 WATER WELL OWNER: Clint Renolett  
 RR#, St. Address, Box #: 3245 W. 47th South. Board of Agriculture, Division of Water Resources  
 City, State, ZIP Code: Wichita, Ks 67217 Application Number:

3 LOCATE WELL'S LOCATION WITH AN "X" IN SECTION BOX:

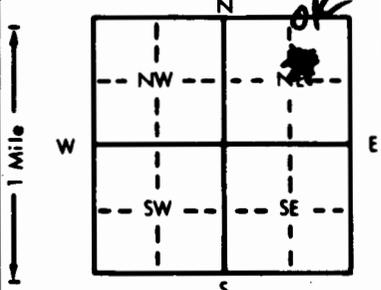

4 DEPTH OF COMPLETED WELL: 60 ft. ELEVATION:

Depth(s) Groundwater Encountered 1. 17 ft. 2. 17 ft. 3. 17 ft.  
 WELL'S STATIC WATER LEVEL 17 ft. below land surface measured on mo/day/yr 4-20-87  
 Pump test data: Well water was 18 ft. after 1/2 hours pumping 20 gpm  
 Est. Yield 25 gpm: Well water was 18 ft. after 1/2 hours pumping 20 gpm  
 Bore Hole Diameter: 11 in. to 60 ft., and 11 in. to 60 ft.  
 WELL WATER TO BE USED AS:  
 1 Domestic  3 Feedlot  6 Oil field water supply  9 Dewatering  12 Other (Specify below)  
 2 Irrigation  4 Industrial  7 Lawn and garden only  10 Observation well  
 Was a chemical/bacteriological sample submitted to Department? Yes No ; If yes, mo/day/yr sample was submitted 4-20-87  
 Water Well Disinfected? Yes  No

5 TYPE OF BLANK CASING USED:

1 Steel  2 PVC  3 RMP (SR)  4 ABS  5 Wrought iron  6 Asbestos-Cement  7 Fiberglass  8 Concrete tile  9 Other (specify below)  CASING JOINTS: Glued  Clamped  Welded  Threaded   
 Blank casing diameter 5 in. to 20 ft., Dia. 5 in. to 20 ft., Dia. 5 in. to 20 ft.  
 Casing height above land surface 12 in., weight 11.59 lbs./ft. Wall thickness or gauge No. SPR-26

TYPE OF SCREEN OR PERFORATION MATERIAL:  
 1 Steel  2 Brass  3 Stainless steel  4 Galvanized steel  5 Fiberglass  6 Concrete tile  7 PVC  8 RMP (SR)  9 ABS  10 Asbestos-cement  11 Other (specify)  12 None used (open hole)

SCREEN OR PERFORATION OPENINGS ARE:  
 1 Continuous slot  2 Louvered shutter  3 Mill slot  4 Key punched  5 Gauzed wrapped  6 Wire wrapped  7 Torch cut  8 Saw cut  9 Drilled holes  11 None (open hole)

SCREEN-PERFORATED INTERVALS: From 20 ft. to 60 ft., From 20 ft. to 60 ft., From 20 ft. to 60 ft., From 20 ft. to 60 ft.  
 GRAVEL PACK INTERVALS: From 13 ft. to 60 ft., From 13 ft. to 60 ft., From 13 ft. to 60 ft., From 13 ft. to 60 ft.

6 GROUT MATERIAL: 1 Neat cement  2 Cement grout  3 Bentonite  4 Other   
 Grout intervals: From 3 ft. to 15 ft., From 3 ft. to 15 ft., From 3 ft. to 15 ft., From 3 ft. to 15 ft.

What is the nearest source of possible contamination:  
 1 Septic tank  4 Lateral lines  7 Pit privy  10 Livestock pens  14 Abandoned water well  
 2 Sewer lines  5 Cess pool  8 Sewage lagoon  11 Fuel storage  15 Oil well/Gas well  
 3 Watertight sewer lines  6 Seepage pit  9 Feedyard  12 Fertilizer storage  16 Other (specify below)  
 13 Insecticide storage  
 Direction from well? NE How many feet? 90

FROM	TO	LITHOLOGIC LOG	FROM	TO	LITHOLOGIC LOG
0	2	Top so.			
2	10	clay.			
10	54	brown chip rock			
54	60	Charcoal shale & clay			

7 CONTRACTOR'S OR LANDOWNER'S CERTIFICATION: This water well was (1) constructed, (2) reconstructed, or (3) plugged under my jurisdiction and was completed on (mo/day/year) 4-20-87 and this record is true to the best of my knowledge and belief. Kansas Water Well Contractor's License No. 318 This Water Well Record was completed on (mo/day/yr) 4-21-87 under the business name of Wenger Brothers by (signature) [Signature]