

WATER WELL RECORD Form WWC-5 KSA 82a-1212


1 LOCATION OF WATER WELL:	Fraction NE $\frac{1}{4}$ SE $\frac{1}{4}$ SE $\frac{1}{4}$	Section Number 30	Township Number T 27 S	Range Number R 3 (EW)
---------------------------	--	----------------------	---------------------------	--------------------------

County: **butler** Distance and direction from nearest town or city street address of well if located within city? **From the SE corner of Sec. 30**

528 ft North, West 40 ft, North 225 ft.

2 WATER WELL OWNER:	Ray Hamill	Board of Agriculture, Division of Water Resources
RR#, St. Address, Box # :	1134 Ginko	Application Number:
City, State, ZIP Code :	Andover, Ks67002	

3 LOCATE WELL'S LOCATION WITH AN "X" IN SECTION BOX:	4 DEPTH OF COMPLETED WELL. .69 ft. ELEVATION:
--	--

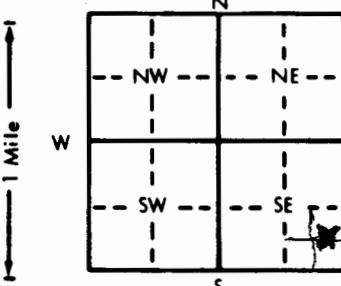

Depth(s) Groundwater Encountered **.39.5** ft. 2. ft. 3. ft.

WELL'S STATIC WATER LEVEL **.21** ft. below land surface measured on mo/day/yr

Pump test data: Well water was ft. after hours pumping gpm

Est. Yield **1.24** gpm: Well water was ft. after hours pumping gpm

Bore Hole Diameter **.10** in. to **.69** ft., and in. to ft.

WELL WATER TO BE USED AS: 5 Public water supply 8 Air conditioning 11 Injection well

Domestic 3 Feedlot 6 Oil field water supply 9 Dewatering 12 Other (Specify below)

2 Irrigation 4 Industrial 7 Lawn and garden only 10 Monitoring well

Was a chemical/bacteriological sample submitted to Department? Yes No If yes, mo/day/yr sample was submitted

Water Well Disinfected? Yes No

5 TYPE OF BLANK CASING USED:	5 Wrought iron	8 Concrete tile	CASING JOINTS: Glued <input checked="" type="checkbox"/> Clamped
------------------------------	----------------	-----------------	--

1 Steel 3 RMP (SR) 6 Asbestos-Cement 9 Other (specify below) Welded

PVC 4 ABS 7 Fiberglass Threaded

Blank casing diameter **.5** in. to **.21** ft., Dia in. to ft., Dia in. to ft.

Casing height above land surface **.18** ft. in., weight **.160** lbs./ft. Wall thickness or gauge No.

TYPE OF SCREEN OR PERFORATION MATERIAL:	<input checked="" type="checkbox"/> PVC	10 Asbestos-cement
---	---	--------------------

1 Steel 3 Stainless steel 5 Fiberglass 8 RMP (SR) 11 Other (specify)

2 Brass 4 Galvanized steel 6 Concrete tile 9 ABS 12 None used (open hole)

SCREEN OR PERFORATION OPENINGS ARE:	5 Gauzed wrapped	<input checked="" type="checkbox"/> Saw cut	11 None (open hole)
-------------------------------------	------------------	---	---------------------

1 Continuous slot 3 Mill slot 6 Wire wrapped 9 Drilled holes

2 Louvered shutter 4 Key punched 7 Torch cut 10 Other (specify)

SCREEN-PERFORATED INTERVALS: From .21 ft. to .69 ft., From ft. to ft.	From ft. to ft., From ft. to ft.
---	--

From ft. to ft., From ft. to ft.

GRAVEL PACK INTERVALS: From .19 ft. to .69 ft., From ft. to ft.	From ft. to ft., From ft. to ft.
---	--

From ft. to ft., From ft. to ft.

6 GROUT MATERIAL: <input checked="" type="checkbox"/> Neat cement 2 Cement grout <input checked="" type="checkbox"/> Bentonite 4 Other
--

Grout Intervals: From **.6.5** ft. to **.3** Neat ft., From **.13** ft. to **.6.5H.P.** ft., From **.19** ft. to **.3** Neat ft.

What is the nearest source of possible contamination:

1 Septic tank 4 Lateral lines 7 Pit privy 10 Livestock pens 14 Abandoned water well

2 Sewer lines 5 Cess pool 8 Sewage lagoon 11 Fuel storage 15 Oil well/Gas well

3 Watertight sewer lines 6 Seepage pit 9 Feedyard 12 Fertilizer storage 16 Other (specify below)

13 Insecticide storage numerous water wells

How many feet? in immediate area

FROM	TO	LITHOLOGIC LOG	FROM	TO	PLUGGING INTERVALS
0	3	Top Soil	60	61	gray clay
3	17	Yellow gray shale with some calcareous stringers	61	64	gray limestone
17	20	Yellow gray shale with interbedded yellow gray limestone	64	65	gray shale
20	22	Yellow gray shale	65	67.5	gray limestone
22	23	Yellow gray limestone	67.5	69	blue gray shale
23	24	Yellow gray shale			
24	39.5	Blue gray shale (almost a blue gray clay)			
39.5	40.5	Gray limestone			
40.5	50	Blue gray shale			
50	60	Gypsum interfaced with hard gray shale with secondary clay interfaces			

7 CONTRACTOR'S OR LANDOWNER'S CERTIFICATION: This water well was (1) constructed, (2) reconstructed, or (3) plugged under my jurisdiction and was completed on (mo/day/year) **8/18/89** and this record is true to the best of my knowledge and belief. Kansas

Water Well Contractor's License No. **.279** This Water Well Record was completed on (mo/day/yr) **8/18/89**

under the business name of **Fudge Drilling** by (signature) **Mehrin R. Fudge**