

WATER WELL PLUGGING RECORD Form WWC-5P

KSA 82a-1212 ID NO.

ACA-2D


1 LOCATION OF WATER WELL: Fraction SE 1/4 NE 1/4 NE 1/4 SE 1/4 Section Number 8 Township Number T 27 S Range Number 3 E W
 County: Butler

Street/Rural Address of Well Location; if unknown, distance & direction from nearest town or intersection: If at owner's address, check here 1511 E. Capital Road, Andover, Ks.

Global Positioning Systems (GPS) information:
 Latitude: 37.7140803 (in decimal degrees)
 Longitude: -97.118634 (in decimal degrees)
 Elevation: NA
 Horizontal Datum: WGS84, NAD83, NAD27
 Collection Method:

2 WATER WELL OWNER: NuStar Pipeline Operating
 RR#, St. Address, Box #: 7340 W. 21st St.
 City, State ZIP Code: Wichita, Ks. 67205

GPS unit (Make/Model: _____)
 Digital Map/Photo, Topographic Map, Land Survey
 Est. Accuracy: < 3 m, 3-5 m, 5-15 m, > 15 m

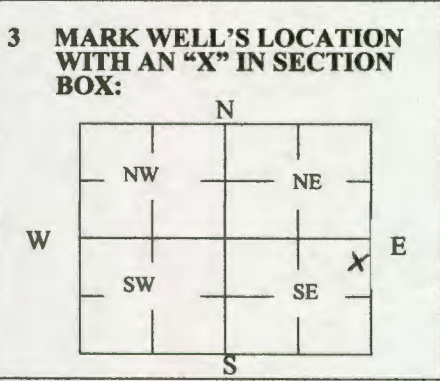

4 DEPTH OF WELL 90.0 ft.
WELL'S STATIC WATER LEVEL 24.7 ft.
WELL WAS USED AS:
 Domestic Irrigation Public Water Supply Dewatering
 Feedlot Oil Field Water Supply Monitoring
 Industrial Domestic (Lawn & Garden) Injection Well
 Air Conditioning Other _____
 Was a chemical/bacteriological sample submitted to Department? Yes No

5 TYPE OF BLANK CASING USED:
 Steel RMP (SR) Wrought Fiberglass Other (Specify below) _____
 PVC ABS Asbestos-Cement Concrete Tile
 Blank casing diameter 2 in. Was casing pulled? Yes No If yes, how much 3 ft.
 Casing height above or below land surface 0 in.

6 GROUT PLUG MATERIAL: Neat cement Cement grout Bentonite Other _____
 Grout Plug Intervals: From 0 ft. to 90.0 ft., From _____ ft. to _____ ft., From _____ ft. to _____ ft.
 What is the nearest source of possible contamination:
 Septic tank Seepage pit Fuel storage Other (specify below) pipeline
 Sewer lines Pit privy Fertilizer storage
 Watertight sewer lines Sewage lagoon Insecticide storage
 Lateral lines Feedyard Abandoned water well Direction from well? NE
 Cess pool Livestock pens Oil well/Gas well How many feet? 10

FROM	TO	PLUGGING MATERIALS	FROM	TO	PLUGGING MATERIALS
0	90.0	Bentonite			

7 CONTRACTOR'S OR LANDOWNER'S CERTIFICATION: This water well was plugged under my jurisdiction and was completed on (mo/day/year) 2/20/2023 and this record is true to the best of my knowledge and belief. Kansas Water Well Contractor's License No. 604. This Water Well Record was completed on (mo/day/year) 3/6/23 under the business name of Environmental Priority Service, Inc. by (signature) [Signature]

Send one white copy to Kansas Department of Health & Environment, Geology Section, 1000 SW Jackson Street, Ste. 420, Topeka, KS 66612-1367. Send one copy to WATER WELL OWNER and retain one for your records.
 Visit us at <http://www.kdheks.gov/waterwell/index.html> Telephone 785-296-5524.

Date: _____

Staff: _____

ID #	Depth to Water (feet below ground surface)	Total Depth (feet below ground surface)
F-1R	27.2	39.6
F-2	27.1	29.8
F-5	DRY	23
F-8	27.5	30.1
F-9	25.8	27.2
F-10	25.6	27
F-11	DRY	25.1
F-12	26.7	28
MW-1R	27.3	40.2
ACA-1S	27.5	35
ACA-1D	28	88.3
ACA-2S	27.2	34.8
ACA-2D	24.7	90
ACA-3S	27.4	35
ACA-3D	26.1	89.8