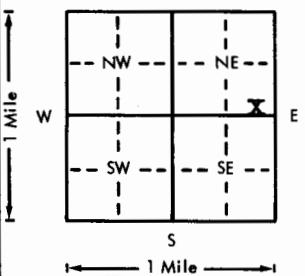


USE TYPEWRITER OR BALL
POINT PEN-PRESS FIRMLY,
PRINT CLEARLY.

WATER WELL RECORD
KSA 82a-1201-1215

Kansas Department of Health and
Environment-Division of Environment
(Water well Contractors)
Topeka, Kansas 66620

1. Location of well:	County	Fraction	Section number	Township number	Range number
Butler		1/4 SE 1/4 NE 1/4	31	T 27 S	R 3E E/W
2. Distance and direction from nearest town or city: 16064 Citation Street address of well location if in city: Wichita, Kansas	3. Owner of well: R.R. or street: City, state, zip code:	R.O. Arnold Const. 14405 Willowbend Circle Wichita, Kansas			
4. Locate with "X" in section below: 	Sketch map: 1/2 South of Harry on RoseHill Rd turn right 3rd house on right.	6. Bore hole dia. 11 in. Completion date 4-11-77 Well depth 62 ft.			
5. Type and color of material	From	To	7. <input type="checkbox"/> Cable tool <input checked="" type="checkbox"/> Rotary <input type="checkbox"/> Driven <input type="checkbox"/> Dug <input type="checkbox"/> Hollow rod <input type="checkbox"/> Jetted <input type="checkbox"/> Bored <input type="checkbox"/> Reverse rotary		
Topsoil	0	3	8. Use: <input type="checkbox"/> Domestic <input type="checkbox"/> Public supply <input type="checkbox"/> Industry <input type="checkbox"/> Irrigation <input type="checkbox"/> Air conditioning <input type="checkbox"/> Stock <input checked="" type="checkbox"/> Lawn <input type="checkbox"/> Oil field water <input type="checkbox"/> Other		
Clay	3	7	9. Casing: Material <input checked="" type="checkbox"/> Styrene Height: Above or below Threaded <input type="checkbox"/> Welded 51 Surface 12 in. RMP <input checked="" type="checkbox"/> PVC Weight _____ lbs./ft. Dia. 5 in. to 62 ft. depth Wall Thickness: inches or Dia. _____ in. to _____ ft. depth gage No. 200		
Shale (Gray)	7	62	10. Screen: Manufacturer's name <input checked="" type="checkbox"/> Sunflower Plastic Type <input checked="" type="checkbox"/> Styrene Dia. 5 ¹ / ₂ Slot/gauge .06 Length 40' Set between 22 ft. and 62 ft. ft. and _____ ft. Gravel pack? <input checked="" type="checkbox"/> yes Size range of material 1-1/8"		
			11. Static water level: 20 ft. below land surface Date 4-11-77		
			12. Pumping level below land surfaces: ft. after _____ hrs. pumping _____ g.p.m. ft. after _____ hrs. pumping _____ g.p.m. Estimated maximum yield _____ g.p.m.		
			13. Water sample submitted: <input type="checkbox"/> Yes <input checked="" type="checkbox"/> No Date _____		
			14. Well head completion: <input checked="" type="checkbox"/> Pitless adapter 12 inches above grade		
			15. Well grouted? <input checked="" type="checkbox"/> yes With: <input type="checkbox"/> Neat cement <input type="checkbox"/> Bentonite <input checked="" type="checkbox"/> Concrete Depth: From 40 ft. to 14 ft.		
			16. Nearest source of possible contamination <input checked="" type="checkbox"/> Septic tank ft. 200 Direction <input checked="" type="checkbox"/> East Type <input checked="" type="checkbox"/> tank Well disinfected upon completion? <input checked="" type="checkbox"/> Yes _____ No _____		
			17. Pump: <input type="checkbox"/> Not installed Manufacturer's name <input checked="" type="checkbox"/> Sta-Rite Model number 20P4D02 HP 3/4 Volts 230 Length of drop pipe 55 ft. capacity 20 g.p.m. Type: <input checked="" type="checkbox"/> Submersible <input type="checkbox"/> Turbine <input type="checkbox"/> Jet <input type="checkbox"/> Reciprocating <input type="checkbox"/> Centrifugal <input type="checkbox"/> Other		
(Use a second sheet if needed)			18. Elevation:	19. Remarks:	
Topography: <input checked="" type="checkbox"/> Hill <input type="checkbox"/> Slope <input type="checkbox"/> Upland <input type="checkbox"/> Valley					20. Water well contractor's certification: This well was drilled under my jurisdiction and this report is true to the best of my knowledge and belief. Harp Well & Pump 236 Business name <input type="checkbox"/> Wichita, Kansas License No. Address <input type="checkbox"/> Signed <input checked="" type="checkbox"/> Authorized representative <input type="checkbox"/> Date 5-5-77