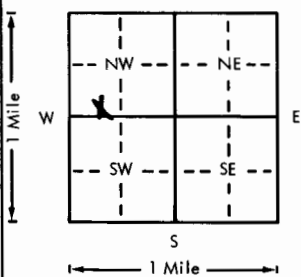


USE TYPEWRITER OR BALL
POINT PEN-PRESS FIRMLY,
PRINT CLEARLY.

WATER WELL RECORD
KSA 82a-1201-1215

Kansas Department of Health and
Environment-Division of Environment
(Water well Contractors)
Topeka, Kansas 66620

BILLED TO: WILSON CONTRACTORS

1. Location of well:	County BUTLER	Fraction 1/4 SW 1/4 NW 1/4	Section number 33	Township number T 27 S	Range number R 3E E/W
2. Distance and direction from nearest town or city: 1 mile south of hwy 54 and Street address of well location if in city: 1 1/8 miles east of the			3. Owner of well: City of Andover Wastewater Treatment Facility R.R. or street: Andover, Kansas City, state, zip code:		
4. Locate with "X" in section below: Andover Road, 1/2 South. Andover, Ks. 			6. Bore hole dia. 11 in. Completion date 11-3-76 Well depth 70 ft.		
5. Type and color of material			7. <input type="checkbox"/> Cable tool <input checked="" type="checkbox"/> Rotary <input type="checkbox"/> Driven <input type="checkbox"/> Dug <input type="checkbox"/> Hollow rod <input type="checkbox"/> Jetted <input type="checkbox"/> Bored <input type="checkbox"/> Reverse rotary		
			8. Use: <input checked="" type="checkbox"/> Domestic <input type="checkbox"/> Public supply <input type="checkbox"/> Industry <input type="checkbox"/> Irrigation <input type="checkbox"/> Air conditioning <input type="checkbox"/> Stock <input type="checkbox"/> Lawn <input type="checkbox"/> Oil field water <input type="checkbox"/> Other		
			9. Casing: Material PVC Height: Above or below 18 in. Threaded <input type="checkbox"/> Welded <input type="checkbox"/> Surface 18 in. RMP <input type="checkbox"/> PVC <input checked="" type="checkbox"/> Weight 3.96 lbs./ft. Dia. 6 in. to 70 ft. depth Wall Thickness: inches or Dia. 6 in. to 70 ft. depth gage No. .316		
			10. Screen: Manufacturer's name PVC NSF approved 200 PSI Type PVC 200PSI Dia. 6" Slot/gage .06 Length 35' Set between 35 ft. and 70 ft. ft. and 1/2-1/8" ft. Gravel pack? yes Size range of material 1/2-1/8"		
			11. Static water level: 30 ft. below land surface Date 11-3-76 mo./day/yr.		
			12. Pumping level below land surfaces: ____ ft. after ____ hrs. pumping ____ g.p.m. ____ ft. after ____ hrs. pumping ____ g.p.m. Estimated maximum yield ____ g.p.m.		
			13. Water sample submitted: ____ mo./day/yr. Yes <input checked="" type="checkbox"/> No <input type="checkbox"/> Date ____		
			14. Well head completion: <input checked="" type="checkbox"/> Pitless adapter 18 inches above grade		
			15. Well grouted? yes 1-2 fine sand mix With: ____ Neat cement ____ Bentonite <input checked="" type="checkbox"/> Concrete Depth: From 40" ft. to 14 ft.		
			16. Nearest source of possible contamination: open cess ft. 40 Direction SE Type pool tank Well disinfected upon completion? <input checked="" type="checkbox"/> Yes ____ No ____		
			17. Pump: Not installed Manufacturer's name customer's pump Model number unknown HP 1/2 Volts 230 Length of drop pipe 45 ft. capacity 10 g.p.m. Type: <input checked="" type="checkbox"/> Submersible ____ Turbine ____ Jet ____ Reciprocating ____ Centrifugal ____ Other		
(Use a second sheet if needed)					
18. Elevation:	19. Remarks: Flat Ground Installed customer's submersible pump and 42 gallon pressure tank. From # 8 above - Water not used for drinking, water used to water mechanical seal and washing sidewalk.		20. Water well contractor's certification: This well was drilled under my jurisdiction and this report is true to the best of my knowledge and belief. Harp Well & Pump 236 Business name Wichita, Kansas License No. ____ Address M. Arnold Signed M. Arnold Date 3-15-79 Authorized representative		

Forward the white, blue and pink copies to the Department of Health and Environment

Form WWC-5