

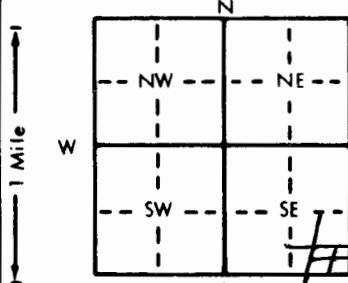
1 LOCATION OF WATER WELL:	Fraction	Section Number	Township Number	Range Number
County: <i>Butler</i>	<i>SE 1/4 SE 1/4 SE 1/4</i>	<i>23</i>	<i>T 27 S</i>	<i>R 30 EW</i>

Distance and direction from nearest town or city street address of well if located within city?

5 west of Augysta

2 WATER WELL OWNER:	<i>Roger Peak</i>	<i>Andover Kan 67002</i>	Board of Agriculture, Division of Water Resources
RR#, St. Address, Box #:	<i>9555 S.W. Meadow Lark</i>	Application Number:	
City, State, ZIP Code			

3 LOCATE WELL'S LOCATION WITH AN "X" IN SECTION BOX:	4 DEPTH OF COMPLETED WELL: <i>187</i> ft. ELEVATION: <i>125</i>
--	---

Depth(s) Groundwater Encountered *125* ft. 2. ft. 3. ft.WELL'S STATIC WATER LEVEL *40* ft. below land surface measured on mo/day/yr

Pump test data: Well water was ft. after hours pumping gpm

Est. Yield *30* gpm. Well water was ft. after hours pumping gpmBore Hole Diameter *7 1/2* in. to ft. and in. to ft.

WELL WATER TO BE USED AS: 5 Public water supply 8 Air conditioning 11 Injection well

1 Domestic 3 Feedlot 6 Oil field water supply 9 Dewatering 12 Other (Specify below)

2 Irrigation 4 Industrial 7 Lawn and garden only 10 Monitoring well

Was a chemical/bacteriological sample submitted to Department? Yes No If yes, mo/day/yr sample was submittedWater Well Disinfected? Yes No

5 TYPE OF BLANK CASING USED:	5 Wrought iron	8 Concrete tile	CASING JOINTS: Glued <input checked="" type="checkbox"/> Clamped <input type="checkbox"/>
1 Steel	6 Asbestos-Cement	9 Other (specify below)	Welded <input type="checkbox"/>
<input checked="" type="checkbox"/> PVC	7 Fiberglass		Threaded <input type="checkbox"/>

Blank casing diameter *5* in. to *60* ft., Dia. in. to ft., Dia. in. to ft.Casing height above land surface *18* in. weight *160* lbs./ft. Wall thickness or gauge No. *214*

TYPE OF SCREEN OR PERFORATION MATERIAL:	7 PVC	10 Asbestos-cement
1 Steel	5 Fiberglass	11 Other (specify) <input type="checkbox"/>
2 Brass	6 Concrete tile	12 None used (open hole) <input type="checkbox"/>

SCREEN OR PERFORATION OPENINGS ARE:	5 Gauzed wrapped	8 Saw cut	11 None (open hole)
1 Continuous slot	6 Wire wrapped	9 Drilled holes	
2 Louvered shutter	7 Torch cut	10 Other (specify) <input type="checkbox"/>	

SCREEN-PERFORATED INTERVALS: From *60* ft. to *187* ft., From ft. to ft. From ft. to ft. From ft. to ft.

GRAVEL PACK INTERVALS: From ft. to ft. From ft. to ft. From ft. to ft. From ft. to ft.

6 GROUT MATERIAL:	1 Neat cement	2 Cement grout	3 Bentonite	4 Other
Grout Intervals:	From <i>0</i> ft. to <i>23</i> ft.	From ft. to ft.	From ft. to ft.	From ft. to ft.

What is the nearest source of possible contamination:

1 Septic tank	4 Lateral lines	7 Pit privy	10 Livestock pens	14 Abandoned water well
2 Sewer lines	5 Cess pool	8 Sewage lagoon	11 Fuel storage	15 Oil well/Gas well
3 Watertight sewer lines	6 Seepage pit	9 Feedyard	12 Fertilizer storage	16 Other (specify below)

Direction from well? *W* How many feet? *100*

FROM	TO	LITHOLOGIC LOG	FROM	TO	PLUGGING INTERVALS
------	----	----------------	------	----	--------------------

<i>0</i>	<i>3</i>	<i>SOIL</i>			
<i>3</i>	<i>12</i>	<i>CLAY</i>			
<i>12</i>	<i>18</i>	<i>Rock & CLAY</i>			
<i>18</i>	<i>30</i>	<i>CLAY</i>			
<i>30</i>	<i>187</i>	<i>Shale & Lime</i>			

7 CONTRACTOR'S OR LANDOWNER'S CERTIFICATION: This water well was constructed, (2) reconstructed, or (3) plugged under my jurisdiction and was completed on (mo/day/year) *12/25/94* and this record is true to the best of my knowledge and belief. KansasWater Well Contractor's License No. *251* This Water Well Record was completed on (mo/day/year) *12/20/94* by (signature) *Charla Winter*
under the business name of *Winter Well Drill*