

WATER WELL RECORD Form WWC-5 KSA 82a-1212

1 LOCATION OF WATER WELL:

County: Butler

Fraction

SW $\frac{1}{4}$ SW $\frac{1}{4}$ NE $\frac{1}{4}$

Section Number

25

Township Number

T 27 S

Range Number

R 3 E

Distance and direction from nearest town or city street address of well if located within city?

3-West of Augusta

2 WATER WELL OWNER:

Terry Ditman Augusta Kay

RR#, St. Address, Box #


R 1 Box 320

Board of Agriculture, Division of Water Resources

City, State, ZIP Code

Application Number:

3 LOCATE WELL'S LOCATION WITH AN "X" IN SECTION BOX:

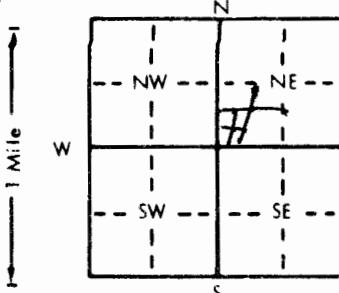

4 DEPTH OF COMPLETED WELL: 167 ft. ELEVATION: _____

Depth(s) Groundwater Encountered 1 140 ft. 2 _____ ft. 3 _____ ft.

WELL'S STATIC WATER LEVEL 65 ft. below land surface measured on mo/day/yr

Pump test data: Well water was _____ ft. after _____ hours pumping _____ gpm

Est. Yield 45 gpm Well water was _____ ft. after _____ hours pumping _____ gpm

Bore Hole Diameter 9 in. to _____ ft. and _____ in. to _____ ft.

WELL WATER TO BE USED AS: 5 Public water supply 8 Air conditioning 11 Injection well

1 Domestic 3 Feedlot 6 Oil field water supply 9 Dewatering 12 Other (Specify below)

2 Irrigation 4 Industrial 7 Lawn and garden only 10 Monitoring well

Was a chemical/bacteriological sample submitted to Department? Yes _____ No _____ If yes, mo/day/yr sample was submitted

Water Well Disinfected? Yes No

5 TYPE OF BLANK CASING USED:

1 Steel 3 RMP (SR)
 PVC 4 ABS5 Wrought iron 8 Concrete tile CASING JOINTS: Glued Clamped 6 Asbestos-Cement 9 Other (specify below) Welded 7 Fiberglass Threaded

Blank casing diameter 5 in. to 50 ft., Dia _____ in. to _____ ft., Dia _____ in. to _____ ft.

Casing height above land surface 18 in., weight _____ lbs./ft. Wall thickness or gauge No. 21.4

TYPE OF SCREEN OR PERFORATION MATERIAL:

1 Steel 3 Stainless steel 5 Fiberglass 8 RMP (SR)
2 Brass 4 Galvanized steel 6 Concrete tile 9 ABS

DVC 10 Asbestos-cement

11 Other (specify) 12 None used (open hole)

SCREEN OR PERFORATION OPENINGS ARE:

1 Continuous slot 3 Mill slot 5 Gauzed wrapped 8 Saw cut 11 None (open hole)
2 Louvered shutter 4 Key punched 6 Wire wrapped 9 Drilled holesDVC 10 Other (specify)

SCREEN-PERFORATED INTERVALS: From 50 ft. to 167 ft., From _____ ft. to _____ ft. From _____ ft. to _____ ft.

From _____ ft. to _____ ft. From _____ ft. to _____ ft. From _____ ft. to _____ ft.

GRAVEL PACK INTERVALS: From _____ ft. to _____ ft. From _____ ft. to _____ ft. From _____ ft. to _____ ft.

From _____ ft. to _____ ft. From _____ ft. to _____ ft. From _____ ft. to _____ ft.

6 GROUT MATERIAL: 1 Neat cement 2 Cement grout 3 Bentonite 4 Other

Grout Intervals: From 0 ft. to 23 ft., From _____ ft. to _____ ft., From _____ ft. to _____ ft., From _____ ft. to _____ ft.

What is the nearest source of possible contamination:

1 Septic tank 4 Lateral lines 7 Pit privy 10 Livestock pens 14 Abandoned water well
2 Sewer lines 5 Cess pool 8 Sewage lagoon 11 Fuel storage 15 Oil well/Gas well
3 Watertight sewer lines 6 Seepage pit 9 Feedyard 12 Fertilizer storage 16 Other (specify below)

13 Insecticide storage

How many feet? 200

Direction from well? S

FROM TO LITHOLOGIC LOG FROM TO PLUGGING INTERVALS

| FROM | TO | LITHOLOGIC LOG | FROM | TO | PLUGGING INTERVALS |
|------|-----|-------------------|------|----|--------------------|
| 0 | 4 | Soil | | | |
| 4 | 15 | Clay | | | |
| 15 | 20 | Rock | | | |
| 20 | 167 | Clay Shale & Lime | | | |