

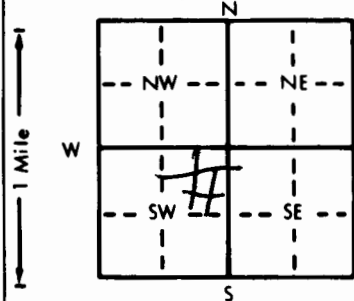
1 LOCATION OF WATER WELL:	Fraction	Section Number	Township Number	Range Number
County: <u>Butler</u>	<u>SE 1/4 NE 1/4 NE 1/4</u>	<u>17</u>	T <u>27</u> S	R <u>4</u> <u>EW</u>

Distance and direction from nearest town or city street address of well, if located within city?

2-W & 2-N of Augusta

2 WATER WELL OWNER:	Board of Agriculture, Division of Water Resources
RR#, St. Address, Box #:	Application Number:
City, State, ZIP Code:	

3 LOCATE WELL'S LOCATION WITH AN "X" IN SECTION BOX:	4 DEPTH OF COMPLETED WELL: <u>125</u> ft. ELEVATION:
--	--

Depth(s) Groundwater Encountered 1 ft. 2. 95 ft. 3. 125 ft.WELL'S STATIC WATER LEVEL 40 ft. below land surface measured on mo/day/yrPump test data: Well water was 50 ft. after 9 1/2 hours pumping 50 gpmEst. Yield 50 gpm: Well water was 50 ft. after 9 1/2 hours pumping 50 gpmBore Hole Diameter 9 1/2 in. to 12 ft., and 12 in. to 12 ft.WELL WATER TO BE USED AS: 5 Public water supply ☒ 8 Air conditioning 11 Injection well

1 Domestic 3 Feedlot 6 Oil field water supply 9 Dewatering 12 Other (Specify below)

2 Irrigation 4 Industrial 7 Lawn and garden only 10 Monitoring well

Was a chemical/bacteriological sample submitted to Department? Yes X No X; If yes, mo/day/yr sample was submittedWater Well Disinfected? Yes X No X

5 TYPE OF BLANK CASING USED:	5 Wrought iron	8 Concrete tile	CASING JOINTS: Glued <u>X</u> Clamped
------------------------------	----------------	-----------------	---------------------------------------

1 Steel 3 RMP (SR) 6 Asbestos-Cement 9 Other (specify below) Welded

2 PVC 4 ABS 7 Fiberglass ThreadedBlank casing diameter 5 in. to 60 ft., Dia 160 in. to 12 1/4 ft., DiaCasing height above land surface 18 in., weight 160 lbs./ft. Wall thickness or gauge No. 12 1/4TYPE OF SCREEN OR PERFORATION MATERIAL: 7 PVC 10 Asbestos-cement

1 Steel 3 Stainless steel 5 Fiberglass 8 RMP (SR) 11 Other (specify)

2 Brass 4 Galvanized steel 6 Concrete tile 9 ABS 12 None used (open hole)

SCREEN OR PERFORATION OPENINGS ARE: 5 Gauzed wrapped 8 Saw cut 11 None (open hole)

1 Continuous slot 3 Mill slot 6 Wire wrapped 9 Drilled holes

2 Louvered shutter 4 Key punched 7 Torch cut 10 Other (specify)

SCREEN-PERFORATED INTERVALS: From 60 ft. to 125 ft., From 125 ft. to 125 ft.GRAVEL PACK INTERVALS: From 60 ft. to 125 ft., From 125 ft. to 125 ft.

7 CONTRACTOR'S OR LANDOWNER'S CERTIFICATION: This water well was (1) constructed, (2) reconstructed, or (3) plugged under my jurisdiction and was completed on (mo/day/year) <u>6/21/96</u> and this record is true to the best of my knowledge and belief. Kansas Water Well Contractor's License No. <u>251</u> This Water Well Record was completed on (mo/day/yr) <u>6/21/96</u> under the business name of <u>Winter Well Drilling</u> by (signature) <u>Charles Winter</u>
--

INSTRUCTIONS: Use typewriter or ball point pen. PLEASE PRESS FIRMLY and PRINT clearly. Please fill in blanks, underline or circle the correct answers. Send top three copies to Kansas Department of Health and Environment, Bureau of Water, Topeka, Kansas 66620-0001. Telephone: 913-296-5545. Send one to WATER WELL OWNER and retain one for your records.