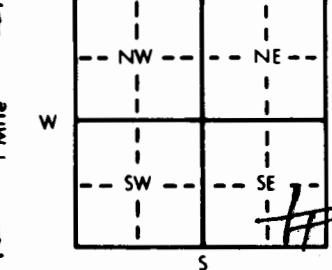


1 LOCATION OF WATER WELL:		Fraction County: <i>Burke</i> <i>SE 1/4 SE 1/4 SE 1/4</i>	Section Number 18	Township Number T 27 S	Range Number R 4 E/W
Distance and direction from nearest town or city street address of well if located within city? <i>2-1/2 N 3-1/2 W of Augusta Kan</i>					
2 WATER WELL OWNER:		<i>BILL Thomas</i> <i>67010</i>		Board of Agriculture, Division of Water Resources Application Number:	
RR#, St. Address, Box #:		<i>3681 SW 100 Augusta Kan</i>			
City, State, ZIP Code					
3 LOCATE WELL'S LOCATION WITH AN "X" IN SECTION BOX:		4 DEPTH OF COMPLETED WELL..... ft. ELEVATION:			
		Depth(s) Groundwater Encountered <i>100</i> ft. 2. ft. 3. ft.			
		WELL'S STATIC WATER LEVEL <i>40</i> ft. below land surface measured on mo/day/yr			
		Pump test data: Well water was ft. after hours pumping gpm			
		Est. Yield <i>5</i> gpm: Well water was ft. after hours pumping gpm			
		Bore Hole Diameter in. to ft., and in. to ft.			
		WELL WATER TO BE USED AS:		5 Public water supply 8 Air conditioning 11 Injection well 6 Oil field water supply 9 Dewatering 12 Other (Specify below) 7 Fiberglass 10 Monitoring well	
		① Domestic 3 Feedlot 2 Irrigation 4 Industrial			
		Was a chemical/bacteriological sample submitted to Department? Yes.....No..... <i>X</i>		If yes, mo/day/yr sample was submitted	
				Water Well Disinfected? Yes <i>X</i> No	
5 TYPE OF BLANK CASING USED:		5 Wrought iron	8 Concrete tile	CASING JOINTS: Glued <i>X</i> Clamped	
1 Steel 3 RMP (SR) ② PVC 4 ABS		6 Asbestos-Cement	9 Other (specify below)	Welded	
Blank casing diameter <i>5</i> in. to <i>45</i> ft., Dia		7 Fiberglass		Threaded.	
Casing height above land surface <i>18</i> in., weight		100	lbs./ft. Wall thickness or gauge No. <i>214</i>		
TYPE OF SCREEN OR PERFORATION MATERIAL:		1 Steel 3 Stainless steel 5 Fiberglass 8 RMP (SR)	10 Asbestos-cement		
2 Brass 4 Galvanized steel 6 Concrete tile 9 ABS		11 Other (specify)			
SCREEN OR PERFORATION OPENINGS ARE:		5 Gauzed wrapped 6 Wire wrapped 7 Torch cut	12 None used (open hole)		
1 Continuous slot 3 Mill slot 2 Louvered shutter 4 Key punched		8 Saw cut 9 Drilled holes	11 None (open hole)		
SCREEN-PERFORATED INTERVALS: From. <i>45</i> ft. to <i>107</i> ft.		10 Other (specify)			
From. ft. to ft., From. ft. to ft.		10 Other (specify)			
GRAVEL PACK INTERVALS: From. ft. to ft., From. ft. to ft.		10 Other (specify)			
From. ft. to ft., From. ft. to ft.		10 Other (specify)			
6 GROUT MATERIAL: 1 Neat cement 2 Cement grout 3 Bentonite 4 Other		10 Livestock pens 11 Fuel storage 12 Fertilizer storage 13 Insecticide storage	14 Abandoned water well 15 Oil well/Gas well 16 Other (specify below)		
Grout Intervals: From. <i>3</i> ft. to <i>23</i> ft., From. ft. to ft., From. ft. to ft.		How many feet? <i>155</i>			
What is the nearest source of possible contamination:					
1 Septic tank 4 Lateral lines 7 Pit privy 2 Sewer lines 5 Cess pool 8 Sewage lagoon 3 Watertight sewer lines 6 Seepage pit 9 Feedyard					
Direction from well? <i>SW</i>					
FROM	TO	LITHOLOGIC LOG	FROM	TO	PLUGGING INTERVALS
<i>0</i>	<i>3</i>	<i>Soil</i>			
<i>3</i>	<i>15</i>	<i>Rock</i>			
<i>15</i>	<i>107</i>	<i>Clay Shale & Lime</i>			
7 CONTRACTOR'S OR LANDOWNER'S CERTIFICATION: This water well was (1) constructed, (2) reconstructed, or (3) plugged under my jurisdiction and was completed on (mo/day/year) <i>1/10/97</i> and this record is true to the best of my knowledge and belief. Kansas					
Water Well Contractor's License No. <i>251</i> This Water Well Record was completed on (mo/day/year) <i>1/10/97</i> by (signature) <i>Charles Winter</i>					