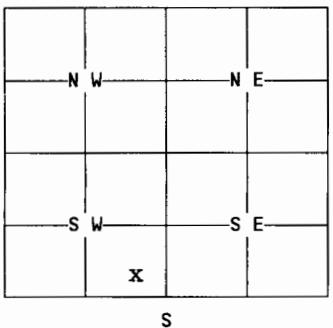


1	LOCATION OF WATER WELL:	Fraction	Section Number	Township Number	Range Number
County: BUTLER		SE 1/4 SE 1/4 SW 1/4	15	27	4E
Distance and direction from nearest town or city street address of well if located within city? 1914 Cron					
2	WATER WELL OWNER:	Forest Reavis			
RR#, St. Address, Box #: 1914 Cron City, State, ZIP Code : Augusta KS 67010			Board of Agriculture, Division of Water Resources Application Number:		
3	MARK WELL'S LOCATION WITH AN "X" IN SECTION BOX: N	4	DEPTH OF WELL.....80.....ft. WELL'S STATIC WATER LEVEL.59.....ft. WELL WAS USED AS: 1 Domestic 5 Public Water Supply 9 Dewatering 2 Irrigation 6 Oil Field Water Supply 10 Monitoring Well 3 Feedlot 7 Lawn and Garden Only 11 Injection Well 4 Industrial 8 Air Conditioning 12 Other.....		
 Was a chemical/bacteriological sample submitted to Department? Yes....No. <input checked="" type="checkbox"/> X If yes, mo/day/yr sample was submitted..... Water Well Disinfected: Yes.. <input checked="" type="checkbox"/> X .. No.....					
5	TYPE OF BLANK CASING USED:				
<input checked="" type="checkbox"/> 1 Steel <input type="checkbox"/> 3 RMP (SR) <input type="checkbox"/> 5 Wrought <input type="checkbox"/> 7 Fiberglass <input type="checkbox"/> 9 Other (specify below) <input checked="" type="checkbox"/> 2 PVC <input type="checkbox"/> 4 ABS <input type="checkbox"/> 6 Asbestos-Cement <input type="checkbox"/> 8 Concrete Tile Blank casing diameter.....6.....in. Was casing pulled? Yes..... No. <input checked="" type="checkbox"/> X... If yes, how much..... Casing height above or below land surface.....30.....in.					
6	GROUT PLUG MATERIAL: 1 Neat cement 2 Cement grout <input checked="" type="checkbox"/> 3 Bentonite 4 Other.....				
Grout Plug Intervals: From....6..ft. to.30". <input checked="" type="checkbox"/> x, From.....ft. toft., From..... to.....ft.					
What is the nearest source of possible contamination:					
1 Septic tank 6 Seepage pit 11 Fuel storage 16 Other (specify below) 2 Sewer lines 7 Pit privy 12 Fertilizer storage <input checked="" type="checkbox"/> 3 Watertight sewer lines 8 Sewage lagoon 13 Insecticide storage 4 Lateral lines 9 Feedyard 14 Abandoned water well 5 Cess Pool 10 Livestock pens 15 Oil well/Gas well Direction from well? ..South..... How many feet?50..... 					
FROM TO PLUGGING MATERIALS			NOTES:		
80'	59'	Sand	Well is located adjacent to house and concrete slab. Landowner ran into rock at 30" below ground.		
59'	6'	Clay/subsoil			
6'	30"	Bentonite	This well had been monitored by KDHE for several years because the well has always had traces of oil and a strong oil smell. No determination was made by KDHE as to where the oil was coming from.		
30"	0'	Topsoil			
7	CONTRACTOR'S OR LANDOWNER'S CERTIFICATION: This water well was plugged under my jurisdiction and was completed on (mo/day/year)..... and this record is true to the best of my knowledge and belief. Kansas Water Well Contractor's License No. This Water Well Record was completed on (mo/day/year)11/21/97..... under the business name of ..Forest.Reavis/.Sandra.Koontz..... by (signature) <u>Sandra Koontz</u>Butler County Conservation District				
INSTRUCTIONS: Use typewriter or ball point pen. Please press firmly and print clearly. Please fill in blanks, underline or circle the correct answers. Send top three copies to Kansas Department of Health and Environment, Bureau of Water, Topeka, Kansas 66620-0001. Telephone: 913/296-3565. Send one to Water Well Owner and retain one for your records.					