

## 1 LOCATION OF WATER WELL:

Fraction

NE  $\frac{1}{4}$ NW  $\frac{1}{4}$ SW  $\frac{1}{4}$ SE  $\frac{1}{4}$ 

Section Number

15

Township Number

T 27 S

Range Number

R 40 EW

County: Butler  
Distance and direction from nearest town or city street address of well if located within city?

IN City

Jack Taylor Augusta Kans

227 West 7th

67010


Board of Agriculture, Division of Water Resources  
Application Number:

## 2 WATER WELL OWNER:

RR#, St. Address, Box #

City, State, ZIP Code

## 3 LOCATE WELL'S LOCATION WITH AN "X" IN SECTION BOX:

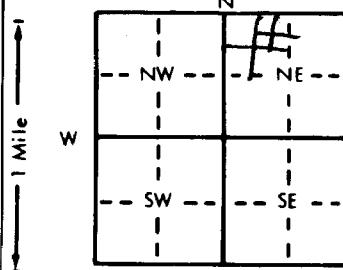

## 4 DEPTH OF COMPLETED WELL:

Depth(s) Groundwater Encountered 167 ft. ELEVATION: ft. 3. ft.

WELL'S STATIC WATER LEVEL 30 ft. below land surface measured on mo/day/yr

Pump test data: Well water was ft. after hours pumping gpm

Est. Yield 10 gpm Well water was ft. after hours pumping gpm

Bore Hole Diameter 9.5 in. to ft. and in. to ft.

WELL WATER TO BE USED AS: 5 Public water supply 8 Air conditioning 11 Injection well

1 Domestic 3 Feedlot 6 Oil field water supply 9 Dewatering 12 Other (Specify below)

2 Irrigation 4 Industrial 7 Lawn and garden only 10 Monitoring well

Was a chemical/bacteriological sample submitted to Department? Yes No If yes, mo/day/yr sample was submitted

Water Well Disinfected? Yes X No

## 5 TYPE OF BLANK CASING USED:

1 Steel 3 RMP (SR)  
2 PVC 4 ABS

5 Wrought iron

6 Asbestos-Cement

7 Fiberglass

8 Concrete tile

9 Other (specify below)

Casing joints: Glued X

Clamped Welded

Blank casing diameter 5 in. to 50 ft. Dia. in. to ft. Dia. in. to ft.

Casing height above land surface in., weight 160 lbs./ft. Wall thickness or gauge No. 12.14

## TYPE OF SCREEN OR PERFORATION MATERIAL:

1 Steel 3 Stainless steel  
2 Brass 4 Galvanized steel

5 Fiberglass

6 Concrete tile

Casing joints: PVC

8 RMP (SR)

9 ABS

10 Asbestos-cement

11 Other (specify)

12 None used (open hole)

## SCREEN OR PERFORATION OPENINGS ARE:

1 Continuous slot 3 Mill slot  
2 Louvered shutter 4 Key punched

5 Gauzed wrapped

6 Wire wrapped

7 Torch cut

8 Saw cut

9 Drilled holes

10 Other (specify)

SCREEN-PERFORATED INTERVALS: From. 50 ft. to 167 ft. From. ft. to ft. From. ft. to ft.

GRAVEL PACK INTERVALS: From. ft. to ft. From. ft. to ft. From. ft. to ft. From. ft. to ft.

From. ft. to ft. From. ft. to ft. From. ft. to ft.

6 GROUT MATERIAL: 1 Neat cement 2 Cement grout 3 Bentonite 4 Other

Grout Intervals: From. 3 ft. to 23 ft. From. ft. to ft. From. ft. to ft. From. ft. to ft.

What is the nearest source of possible contamination:

1 Septic tank	4 Lateral lines	7 Pit privy	10 Livestock pens	14 Abandoned water well
2 Sewer lines	5 Cess pool	8 Sewage lagoon	11 Fuel storage	15 Oil well/Gas well
3 Watertight sewer lines	6 Seepage pit	9 Feedyard	12 Fertilizer storage	16 Other (specify below)

Direction from well?

13 Insecticide storage

How many feet? 60

FROM TO LITHOLOGIC LOG FROM TO PLUGGING INTERVALS

3 30 50 ft. rock

10 25 clay

25 167 shale/lime

7 CONTRACTOR'S OR LANDOWNER'S CERTIFICATION: This water well was (1) constructed, (2) reconstructed, or (3) plugged under my jurisdiction and was completed on (mo/day/year) 3/26/01 and this record is true to the best of my knowledge and belief. Kansas

Water Well Contractor's License No. 257 This Water Well Record was completed on (mo/day/year) 4/6/01  
under the business name of Winter Well Drill by (signature) Charles Winter

INSTRUCTIONS: Use typewriter or ball point pen. PLEASE PRESS FIRMLY and PRINT clearly. Please fill in blanks, underline or circle the correct answers. Send top three copies to Kansas Department of Health and Environment, Bureau of Water, Topeka, Kansas 66620-0001. Telephone: 913-296-5545. Send one to WATER WELL OWNER and retain one for your records.